

Benton  
 H25  
 9-66

MISSISSIPPI  
 BOARD OF WATER COMMISSIONERS  
 416 North State Street  
 Jackson, Mississippi 39201

WATER WELL DRILLERS LOG

**CODED**

9-2 1966 Robert W. Wilson  
 date well completed firm name county well located

LANDOWNER Benton Co. Educ. Center  
Ashland  
Miss.  
 (mailing address)


description of formations encountered	from	to
Red clay	0	10
Red Sand	20	70
Red Sand + clay (white)	70	80
White clay	80	145

WELL LOCATION:  
 sec. 2 T. 3 N. R. 1 E.  
1 miles N of Ashland  
 (distance) (direction) (nearest town)

WELL PURPOSE: home  
 (home, irrigation, municipal, industrial)

- WELL COMPLETION DATA:
- (1) diameter (inches) 4"
  - (2) total depth (feet) 145'
  - (3) static water level (feet) 98 <sup>below</sup> <sub>above</sub> top of ground.
  - (4) casing plastic, 133'  
 (material) (depth)  
4"  
 (size) If telescope see back.
  - (5) screen 12', 133'  
20gaw (length) (depth to top)  
4", Gal. Pac Slotted Pipe  
 (size) (material)
  - (6) pump 1/2  
 (HP) (yield gpm)  
Elect.  
 (type power)
  - (7) electric log NO  
 (yes or no)  
 (organization running log)
  - (8) how well bottom plugged 4"  
plastic cap

**CODED**

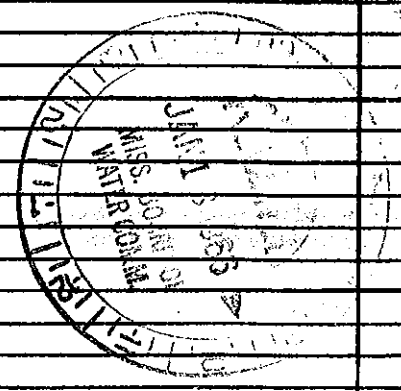

DRILLERS REMARKS: