

Benton
H26
9-66

MISSISSIPPI
 BOARD OF WATER COMMISSIONERS
 416 North State Street
 Jackson, Mississippi 39201

CODED

WATER WELL DRILLERS LOG

9-13-66 Robert M. Wilson Benton
 date well completed firm name county well located

LANDOWNER: Park Kenery
Ashland
Miss.
 (mailing address)

description of formations encountered	from	to
<u>Red clay</u>	<u>0</u>	<u>20</u>
<u>Red sand</u>	<u>20</u>	<u>60</u>
<u>White sand + clay</u>	<u>60</u>	<u>92</u>


WELL LOCATION:
 sec. 21 T 3 N R 1 E
4 miles S of Ashland
 (distance) (direction) (nearest town)

WELL PURPOSE: Home
 (home, irrigation, municipal, industrial)

WELL COMPLETION DATA:

(1) diameter (inches) 4"
 (2) total depth (feet) 90"
 (3) static water level (feet) 68 below above top of ground.
 (4) casing Plastic, 86'
 (material) (depth)
4" If telescope see back.
 (size)
 (5) screen 4', 86'
20gws (length) (depth to top)
4" Sub. Pac. Slotted Pipe
 (size) (material)
 (6) pump 1/2 (HP) (yield gpm)
Elect.
 (type power)
 (7) electric log NO
 (yes or no)
 (organization running log)
 (8) how well bottom plugged 4"
Plastic cap

CODED

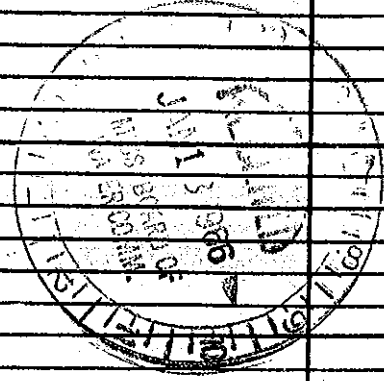

DRILLERS REMARKS: