

Benton
H27
11-66

MISSISSIPPI
BOARD OF WATER COMMISSIONERS
416 North State Street
Jackson, Mississippi 39201

WATER WELL DRILLERS LOG

CODED

11-21-1966 Robert W. Wilson Benton
date well completed firm name county well located

LANDOWNER: Mar Gibson
Oakland
Miss.
(mailing address)


description of formations encountered	from	to
Red Clay & Sand	0	10
Red Sand	10	100
Red Clay & White Sand	100	110
White Sand	110	137

WELL LOCATION:
sec. 6 T. 3 N. R. 1 E.
3 miles W of Old Salem School
(distance) (direction) (nearest town)

WELL PURPOSE: Home
(home, irrigation, municipal, industrial)

- WELL COMPLETION DATA:
- (1) diameter (inches) 4"
 - (2) total depth (feet) 137'
 - (3) static water level (feet) 98 below above top of ground.
 - (4) casing Plastic, 133'
(material) (depth)
4"
(size) If telescope see back.
 - (5) screen 4', 133'
(length) (depth to top)
4", Gal. Pac. Slotted Pipe
(size) (material)
 - (6) pump 1/2 (HP) (yield gpm)
Elect.
(type power)
 - (7) electric log NO
(yes or no)
(organization running log)
 - (8) how well bottom plugged 4"
Plastic cap

CODED

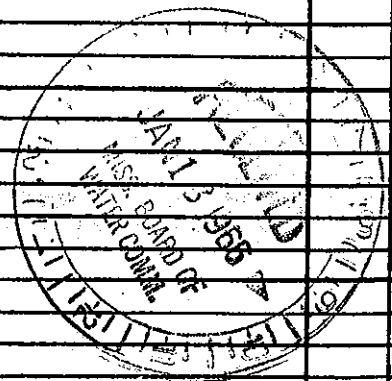

DRILLERS REMARKS: