

Benton
 H 33
 6-66

MISSISSIPPI
 BOARD OF WATER COMMISSIONERS
 416 North State Street
 Jackson, Mississippi 39201

WATER WELL DRILLERS LOG

6-27 1966 Robert W. Wilson Benton
 date well completed firm name county well located


LANDOWNER: Sam Farrow
 Oakland
 Miss.
 (mailing address)

WELL LOCATION:
 sec. 16 T. 3 N R. 1 E
 1/2 miles S of Stroupeville
 (distance) (direction) (nearest town)

WELL PURPOSE: home
 (home, irrigation, municipal, industrial)

- WELL COMPLETION DATA:
- (1) diameter (inches) 4"
 - (2) total depth (feet) 179'
 - (3) static water level (feet) 148 below top of ground.
 - (4) casing Plastic 175' (material) (depth)
 4" (size) If telescope see back.
 - (5) screen 4' 175' (length) (depth to top)
 20 gage (size) Gravel Pvc Slotted Pipe (material)
 - (6) pump 3/4 (HP) (yield gpm)
 Elect. (type power)
 - (7) electric log NO (yes or no)
 (organization running log)
 - (8) how well bottom plugged 4"
 Plastic cap

description of formations encountered	from	to
Red dirt	0	10
Red Sand	10	30
Red sand & clay	30	40
Red sand	40	80
White clay	80	110
White clay & sand	110	150
White sand	150	179

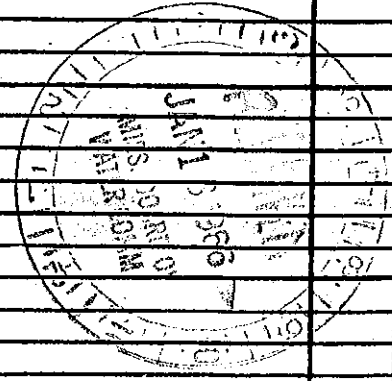

DRILLERS REMARKS: