


ALL MEASUREMENTS TAKEN FROM (GROUND)

Drawing of the Well

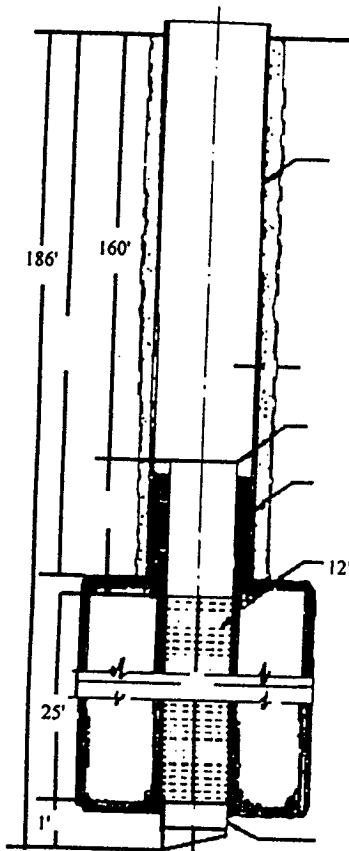

WELL DATA	Started Well <u>6-12-01</u> <u>20</u> <u>01</u> And Completed <u>6-18</u> <u>20</u> <u>01</u> Total Depth <u>186'</u> Elevation _____ Static Water Level <u>122'</u> Length Surface Casing <u>26'</u> Size <u>50"</u> Thickness <u>.375</u> Cemented with <u>4 pallet portland</u> Cement Type Packer _____ Length Well Casing <u>160'</u> Size <u>12"</u> Weight <u>.375</u> Cemented with <u>BULK</u> Cement Type Packer _____ Inner Casing Length _____ Size _____ Weight _____ With _____ Guides Located _____ Type Backoff _____ Lead Seal _____ BackPressure Valve <u>NONE</u> Length <u>25'</u> Well Strainer _____ Make <u>HOUSTON</u> <u>WW</u> Size <u>12"</u> Length <u>25'</u> Opening <u>0.040</u> Type Material <u>SS</u> With <u>Welded</u> Connections _____ Size Hole Drilled for Surface Casing <u>32"</u> With <u>Drag</u> _____ Size Hole Drilled for Well Casing <u>23"</u> With <u>Drag</u> _____ Size Hole Drilled for Strainer _____ With _____ Yards of Gravel Used <u>14 super sack</u> How Placed <u>Gravel LINE</u> <u>8-16</u> How was well developed <u>Air Agitation</u> Foundation Installed _____ Notes: <u>Gravel well 5' to top cement plug on top</u> Depth Feeling Line Rods _____ Notes: _____ Rig Used <u>Jet A</u> Driller <u>Barry Crook</u> Supt <u>John Oswalt</u>
PUMP RECORD	Serial Number _____ Make _____ Foundation _____ Length Column _____ Size _____ Type _____ @ _____ Lengths _____ Bowl Size _____ Type _____ Stages _____ Material _____ Impeller _____ Material Bowl _____ With _____ Ports and _____ Shaft _____ Suction Size _____ Length _____ Suction Strainer _____ Is Pump Sealed How _____ Where _____ With What _____ Lubricator Type _____ Size _____ Voltage _____ Length of Airline _____ Size _____ Type Material _____ Air Release Valve Type _____ Size _____ Size Surface Discharge _____ Type _____ Dayton Coupling _____ Pressure Gauge _____ Speed _____ Notes _____ Rig Used to Set Pump _____ Installer _____ Date Pump Installed _____ 20 _____ Date In Operation _____ 20 _____
MOTOR	Make _____ HP _____ Frame _____ Phase _____ Cycle _____ Volt _____ Speed _____ Model _____ Serial Number _____ Top Bearing _____ Bottom Bearing _____ Ratchet _____ Starter _____ Pressure Switch _____ Float _____
GEAR	Make _____ Model _____ HP _____ Serial Number _____ Size Pulley _____ Type Motor Frame _____
ENGINE	Make _____ Model _____ HP _____ Serial Number _____ Speed _____ Size Pulley _____ Foundation _____ Type Fuel Tank _____ Make Mag _____ No. _____ Make Starter _____ No. _____ Type Fuel _____ Make Flexible Shaft _____ Size _____ Length _____ Belt Length _____
GENERAL	Purpose for which this water is used _____ Temperature _____ Is Water Clear <u>Yes</u> Capacity _____ Sand <u>No</u> Hardness _____ PH _____ Iron _____ NaCl _____ _____ Type Treatment used _____ Is there a derrick over the well _____ Height _____ Type _____ Can a Truck or Rig easily get to the well _____ Pump House _____ Size Hatch _____

CONTRACT NO 57 - 5094

Our Well No. _____ Their Well No. _____ In Test Hole No. 1

Location of the Well Bolden #1

Installed For Magnolia Energy

Address City Ashland County Benton State MS

RECEIVED
 NOV 12 2002
 BY: OLWR

Year 2001