

STATE WELL REPORT

Part 1

Driller's Log

Mississippi Department of Environmental Quality
Office of Land and Water Resources
P.O. Box 2309
Jackson, MS 39225-2309
(601)961-5210
(601)360-0535 (fax)

For Office Use Only:

Well #: H95
Aquifer: _____
E-Log #: _____

County: Benton
Permit #: _____
Driller: LOA' Gary Smith
Date drilling completed: 7-11-2016

State Law requires that this report be prepared by the license holder responsible for the work and filed with the Department at the above address within 30 days of completion of drilling of the well or borehole.

Well Owner Information (Landowner if borehole is not for a water well)	Well or Borehole Location
Owner Name: <u>Steve Burge</u>	Latitude: <u>34-7947</u> Longitude: <u>89.1429</u>
Mailing Address: <u>379 Rogers loop</u>	<u>3A-47-41</u> <u>89-08-34</u>
<u>Ashland</u> <u>MS</u> <u>38603</u>	Method of Lat/Long (check one): Conventional Survey _____
City State Zip Code	USGS quad _____, Hand-held GPS <input checked="" type="checkbox"/> , Survey-grade GPS _____
Telephone No. <u>(901) 299-9345</u>	<u>SE 1/4 NE 1/4</u> , Sec <u>25</u> T <u>35</u> R <u>1E</u>
	<u>2.8</u> Miles <u>NE</u> of <u>Ashland MS</u>
	(Distance) (Direction) (Nearest Town)

Well / Borehole Data

Date drilling started: 7-11-16 Date drilling completed: 7-11-16 Hole depth: 670' Hole diameter: 4"

Location of the source of any surface water used for drilling: N/A

Method of dosing and volume of Chlorine used in drilling and development: 10 LBS HTH Chlorine

Logs run (circle all applicable) No log run Electric Gamma Ray Density Sonic Neutron Other: _____

Name of organization running log(s): _____

Purpose of borehole (circle one) Water Well Geotechnical/Geological Investigation Ground Source Heat Pump

Seismic Survey Other (describe) _____

If drilling is not related to water well construction, skip the remainder of this block

Purpose of Well (circle all applicable): Home Industrial Public Supply Irrigation Fish Culture

Other (describe): _____

If a flowing well, method of flow regulation: Valve N/A Other (describe) N/A

Static Water Level: 90 feet [above or below] land surface Date measured: 7-11-2016

(circle one)

Method of measurement (circle one): Steel tape Electric tape Air line Other (describe): _____

Well depth: 670 Well grouted to a depth of: 50 feet Type of grout (circle one): Neat Cement Bentonite Mix

Casing length: 220 feet Casing diameter: 4" inches Type of casing: PVC

Screen length: 40 feet Screen diameter: 2 inches Type of screen: Stainless Steel

Screen slot size: -0/3 inches Setting depth: From 630 feet to 670 feet

Type of completion (circle all applicable) Gravel packed Underreamed Open hole Natural Development

Other (describe): _____

Top of lap pipe or reduction in casing: _____ feet

If telescoped or more than one screen, describe on next page

Received

AUG 01 2016


By OLWR

County: Benton
 Permit #: _____

For Office Use Only:
 Well #: H95

The sketch below only required for water wells

If well telescopes, show depths on sketch.

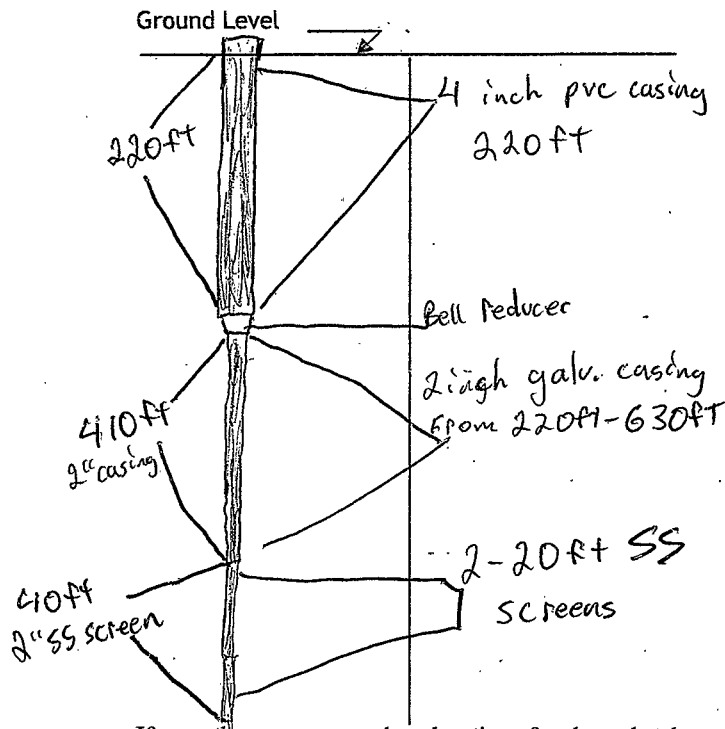


If more than one screen, show location of each on sketch

Description of formations encountered must be provided for all wells and boreholes, unless specifically exempted by regulations

Description of Formations Encountered	From (depth)	To (depth)
Red and Red Sand	Ground level	100ft
Red sand and gravel	100ft	200ft
Brown clay	200ft	250ft
gray clay and sand	250ft	300
gray clay fine sand	300	400
Rock	400	430
Fine sand and clay	430	520
Fine sand	520	630
Coarse sand	630	670

Sketch the property layout and include the following:

- 1) the well location
- 2) any permanent structures on the property that may aid in locating the well
- 3) any roads, power lines, or other items that may aid in locating the property and the well
- 4) north arrow

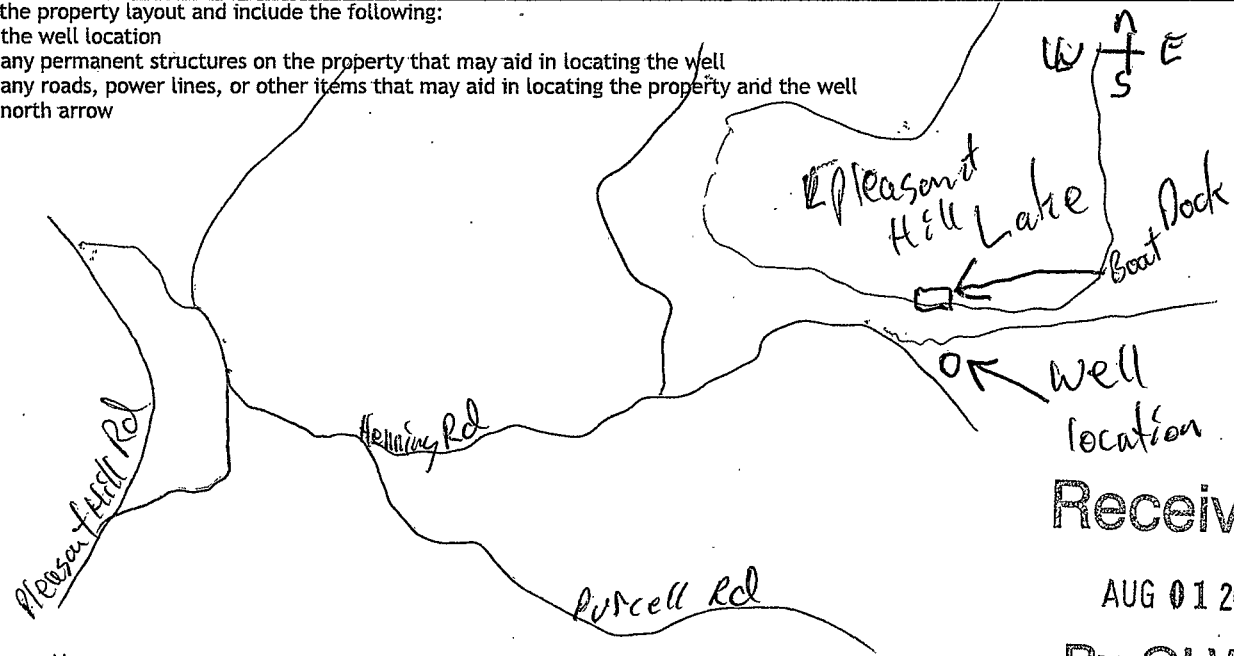

Received
 AUG 01 2016
 By OLWR

Landowner Name: _____

I HEREBY CERTIFY that the well/borehole was drilled, constructed, and completed in accordance with all applicable requirements of the Mississippi Department of Environmental Quality and the Mississippi Department of Health regulations, if applicable, and state laws.

Gacy Smith UNR-00006595 2-27-2016
 Print Name of Responsible Licensee and License No. Date Signature of Licensee

STATE WELL REPORT

Part 2

Pump Installer's Completion Report
 Mississippi Department of Environmental Quality
 Office of Land and Water Resources
 P.O. Box 2309
 Jackson, MS 39225-2309
 (601)961-5210
 (601) 360-0535 (fax)

County: Heaton
 Permit #: _____
 Driller: Water Well Solutions
 Date completed: 7-12-2016
Copy information from block on Part 1

For Office Use Only:

Well #: H95
 Aquifer: _____

This part of the report must be completed by a licensed water well contractor or a licensed pump installer. A copy of Part 1 of the report must be attached and both parts filed with the Department at the above address within 30 days of well completion.

Well Owner Information	Well Location
Owner Name: <u>Steve Borge</u>	Latitude: <u>34.7947</u> Longitude: <u>89.1429</u>
Mailing Address: <u>379 Rodgers loop</u>	<u>34-47-41</u> <u>89-08-34</u> Method of Lat/Long (check one): Conventional Survey _____
<u>Ashland</u> <u>MS</u> <u>38603</u>	USGS quad _____, Hand-held GPS <input checked="" type="checkbox"/> , Survey-grade GPS _____
City State Zip Code	<u>SE 1/4 NE 1/4, Sec 25 T 35 R 1E</u>
Telephone No. <u>(901) 299 - 9345</u>	<u>2.8</u> Miles <u>NE</u> of <u>Ashland</u> (Distance) (Direction) (Nearest Town)

Pump Type (circle one)

Submersible Turbine Air Lift Centrifugal Flowing Well Jet Piston Rotary Other (describe): _____

Date Pump Installed: 7-12-2016 Rated Pump Capacity: 25 Gallons Per Minute

Is This Pump (circle one): New Repaired Replacement

Power Type (circle one)

Electric Diesel Gasoline Natural Gas Tractor PTO Windmill Other (describe): _____

Horse Power Rating of Motor: _____ Setting Depth: _____ feet Number of Stages: _____

Pump Test Data for Non Flowing Well

Date Well Tested: 7-12-2016 Duration of Pump Test (minimum 4 hours): 5 hours

Static Water Level (A): 90 Feet Below Land Surface Pumping Water Level (B): 120 Feet Below Land Surface

Drawdown [(B) - (A)]: 30 Feet Below Land Surface Test Pumping Rate: 32 Gallons Per Minute

Method of measurement (circle one): Steel tape Electric tape Air line Other (describe): _____

Pump Test Data for Flowing Well

Measured shut in head: _____ feet.

Well yielded _____ GPM with a drawdown of _____ feet after _____ hours of pumping

Meter Installation

Meter Manufacturer: _____ Meter Serial Number: _____

Meter Model Number/Name: _____ Type of Meter: _____

Totalizer Register Unit and Multiplier Factor (AF x .001, gal x 1000, etc): _____

Installation Date: _____ Meter installed by: _____

Is This Meter (circle one): New Repaired Replacement

Important: By submitting the above information you are certifying that this meter was installed to manufacturer standards. For agricultural wells, a list of approved meters is on the MDEQ website.

I HEREBY CERTIFY that the above statements are true to the best of my knowledge.

Gary Smith / UNR-00006595 7-27-2016 [Signature]
 Print Name of Pump Installer and License No. (if applicable) Date Signature of Pump Installer

Form: OLWR-SWR-2A (4/13)
 Received
 AUG 01 2016
 By OLWR