

BENTON MISSISSIPPI BOARD OF WATER COMMISSIONERS

H 1001


WATER WELL DRILLERS LOG

6-25-64

Date: 6-25, 1964, Driller: Robert Wilson County Benton

(Name)

| | | Description & Color of Materials Sand, Clay, Red Clay, Shell, etc. | Thick- ness Feet | Depth Feet |
|--|--|---|------------------------|---------------|
| (1) Owner of Land: <u>City of Ashland</u> (Name) | | Red dirt | 0 | 20 |
| <u>Ashland</u> (Address) | | " sand | 20 | 80 |
| (2) Location: _____ 1/4, _____ 1/4, Sec. _____ T. R. _____ | | white " | 80 | 90 |
| _____ miles _____, of <u>Ashland</u> (distance) (direction) (Nearest Town) | | " clay | 90 | 100 |
| (3) Topography: <input checked="" type="checkbox"/> (Hilly) <input type="checkbox"/> (Flat) <input type="checkbox"/> (Level) | | Red sand | 100 | 130 |
| (4) Purpose of Well: (Domestic Irrigation Municipal, Industrial, Other) | | white " | 130 | 198 |
| Information upon completion of well: | | | | |
| (1) Diameter <u>6</u> inches. | | | | |
| (2) Total Depth <u>198</u> feet. | | | | |
| (3) Water Level <u>135</u> feet below top of ground. | | | | |
| (4) Cased to <u>198</u> , Size <u>6</u> | | | | |
| (5) Screen: Size <u>6</u> , Length <u>18</u> | | | | |
| (6) Were any formations sealed against pollution? <u>X</u> yes, _____ no. | | | | |
| If YES depth of formation <u>30'</u> | | | | |
| Why <u>safety precautions</u> | | | | |
| Drillers Remarks: | | | | |

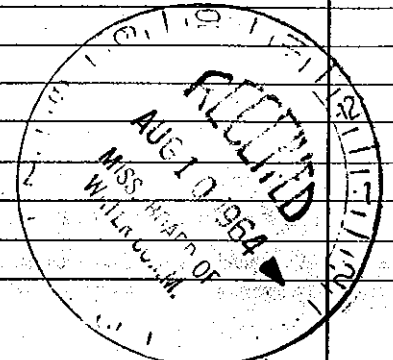

(Use Back Side)

Well No.

Mail this copy to Board of Water Commissioners 429 Miss. St. Jackson, Miss.