

BENTON

MISSISSIPPI BOARD OF WATER COMMISSIONERS

H 1002
9-3-62

WATER WELL DRILLERS LOG

Date: Sept 3, 1962, Driller: Robert W. Wilson County Benton

(Name)

		Description & Color of Materials Sand, Clay, Red Clay, Shell, etc.	Thick- ness Feet	Depth Feet
(1) Owner of Land: <u>Benton Co. Fair Grounds</u> (Name)		<u>Red Sand</u>	<u>40</u>	<u>0-40</u>
<u>Ashland, Miss</u> (Address)		<u>White Sand</u>	<u>40</u>	<u>40-80</u>
(2) Location: <u>1/4</u> , <u>1/4</u> , Sec. <u>T</u> <u>R</u>		<u>White Clay</u>	<u>40</u>	<u>80-120</u>
<u>1</u> miles <u>N</u> , of <u>Ashland</u> (distance) (direction) (Nearest Town)		<u>White Sand</u>	<u>40</u>	<u>120-160</u>
(3) Topography: <u>Y</u> (Hilly) (Flat) (Level)				
(4) Purpose of Well: <u>Fair Ground Use</u> (Domestic Irrigation Municipal, Industrial, Other)				


Information upon completion of well:

- (1) Diameter 6 inches.
- (2) Total Depth 160 feet.
- (3) Water Level 120' feet below top of ground.
- (4) Cased to 160, Size 6
- (5) Screen: Size 6", Length 10'
- (6) Were any formations sealed against pollution?
no

If YES depth of formation _____

Why _____

Drillers Remarks: _____

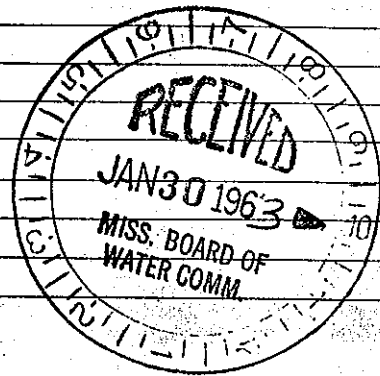

(Use Back Side)

Well No.

Mail this copy to Board of Water Commissioners 429 Miss. St. Jackson, Miss