

BENTON

H 2000

MISSISSIPPI BOARD OF WATER COMMISSIONERS

HP

10-12-60

WATER WELL DRILLERS LOG

Date: Oct. 12, 1960, Driller: Robert W. Wilson

County: Benton

(Name) _____

(1) Owner of Land: W.B. Rogers
 (Name) Fishland, Miss.
 (Address) _____

(2) Location: $\frac{1}{4}$, $\frac{1}{4}$, Sec. T R
4 miles South of Fishland
 (distance) (direction) (Nearest Town)


(3) Topography: Home
 (Hilly) (Flat) (Level)

(4) Purpose of Well: _____
 (Domestic Irrigation, Municipal, Industrial, Other)

Information upon completion of well:
 (1) Diameter 4 inches.
 (2) Total Depth 163 feet.
 (3) Water Level 145 feet below top of ground.
 (4) Cased to 163', Size 4"
 (5) Screen: Size 4", Length 6'
 (6) Were any formations sealed against pollution?
X yes, _____ no.

If YES depth of formation _____
 Why _____
 Drillers Remarks: _____

Description & Color of Materials Sand, Clay, Red Clay, Shell, etc.	Thick- ness Feet	Depth Feet
Red Clay	10'	0-10'
Rock	6'	10-16'
Red Sand	84'	16-100'
White Sand	25'	100-125'
Rock	1'	125-126'
White Clay	10'	126-136'
White Sand	17'	136-153'

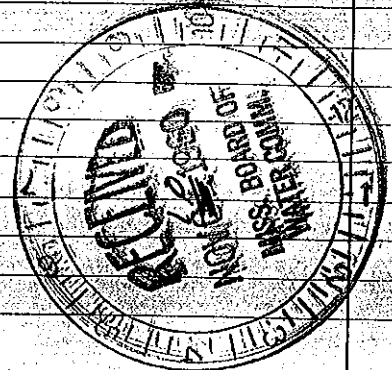

(Use Back Side)

Well No.

Mail this copy to Board of Water Commissioners 429 Miss. St. Jackson, Miss.