

BENTON

MISSISSIPPI BOARD OF WATER COMMISSIONERS

H 2004

2-17-62

WATER WELL DRILLERS LOG

Date: 2-17, 1962, Driller: Robert W. Wilson, County: Benton

JACK Creasta (Name)

(1) Owner of Land: Jack Creasta (Name) Ashland, Miss (Address)

Description & Color of Materials Sand, Clay, Red Clay, Shell, etc.	Thick- ness Feet	Dept Feet
Red Clay	20	0-2
White Sand	136	20-1

(2) Location: 3 miles W of Ashland (distance) (direction) (Nearest Town)

(3) Topography: Flat (Level)

(4) Purpose of Well: Home (Domestic Irrigation, Municipal, Industrial, Other)


Information upon completion of well:

- (1) Diameter 4 inches.
- (2) Total Depth 152 feet.
- (3) Water Level 135 feet below top of ground.
- (4) Cased to 152, Size 4"
- (5) Screen: Size 4, Length 6'
- (6) Were any formations sealed against pollution? yes, X no.

If YES depth of formation

Why

Drillers Remarks:

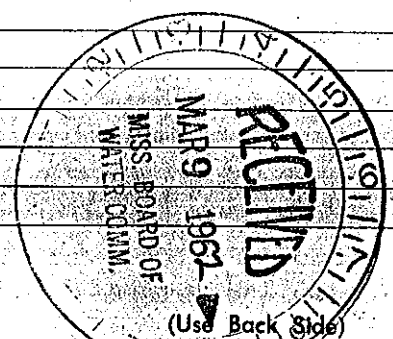

Well No.

Mail this copy to Board of Water Commissioners 429 Miss. St. Jackson, Miss