


**BENTON** MISSISSIPPI BOARD OF WATER COMMISSIONERS

**H 2005**  
**2-20-62** WATER WELL DRILLERS LOG

Date: Feb 20, 1962, Driller: Robert W. Wilson County Benton

(Name)

(1) Owner of Land: <u>Louison Mathis</u> (Name)	Description & Color of Materials Sand, Clay, Red Clay, Shell, etc.	Thick- ness Feet	Depth Feet
<u>Ashland, Miss</u> (Address)	<u>Red Sand</u>	<u>30'</u>	<u>0-30</u>
(2) Location: _____ 1/4, _____ 1/4, Sec. _____ T R _____	<u>White Clay</u>	<u>10'</u>	<u>30-100</u>
<u>4</u> miles <u>S</u> of <u>Ashland</u> (distance) (direction) (Nearest Town)	<u>White Sand</u>	<u>43'</u>	<u>100-143</u>
(3) Topography: <input checked="" type="checkbox"/> (Hilly) <input type="checkbox"/> (Flat) <input type="checkbox"/> (Level)			
(4) Purpose of Well: <u>Home</u> (Domestic Irrigation Municipal, Industrial, Other)			
Information upon completion of well:			
(1) Diameter <u>4</u> inches.			
(2) Total Depth <u>143</u> feet.			
(3) Water Level <u>100'</u> feet below top of ground.			
(4) Cased to <u>143'</u> , Size <u>4"</u>			
(5) Screen: Size <u>4"</u> , Length <u>6'</u>			
(6) Were any formations sealed against pollution? _____ yes, <input checked="" type="checkbox"/> no.			
If YES depth of formation _____			
Why _____			
Drillers Remarks: _____ _____ _____			

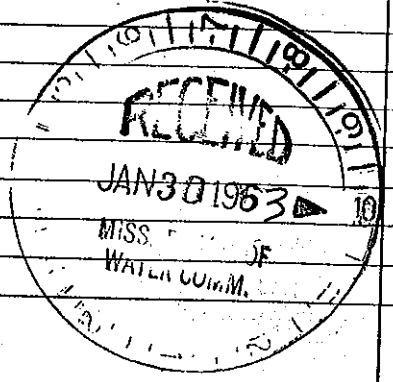

(Use Back Side)

Well No.

Mail this copy to Board of Water Commissioners 429 Miss. St. Jackson, Miss