


BENTON MISSISSIPPI BOARD OF WATER COMMISSIONERS

H 2006
2-20-62

WATER WELL DRILLERS LOG

Date: 2-20, 19 62 Driller: Robert W. Wilson County Benton

		Description & Color of Materials Sand, Clay, Red Clay, Shell, etc.	Thick- ness Feet	Depth Feet
(1) Owner of Land: <u>Edwison Mathis</u> (Name) <u>A Shiloh, Miss</u> (Address)		<u>Red Clay</u>	<u>20</u>	<u>0-20</u>
		<u>Red Sand</u>	<u>50</u>	<u>20-70</u>
(2) Location: <u>1/4</u> , <u>1/4</u> , Sec. <u>T R</u> <u>4</u> miles <u>S</u> of <u>Ashtand</u> (distance) (direction) (Nearest Town)		<u>Clay (white)</u>	<u>20</u>	<u>70-90</u>
		<u>Wh. Sand</u>	<u>53</u>	<u>90-143</u>
(3) Topography: <u>FLAT</u> (Hilly) (Flat) (Level)				
(4) Purpose of Well: <u>Home</u> (Domestic Irrigation Municipal, Industrial, Other)				
Information upon completion of well:				
(1) Diameter <u>4</u> inches.				
(2) Total Depth <u>143</u> feet.				
(3) Water Level <u>120</u> feet below top of ground.				
(4) Cased to <u>143</u> , Size <u>4</u>				
(5) Screen: Size <u>4"</u> , Length <u>6'</u>				
(6) Were any formations sealed against pollution? <u>X</u> yes, <u>no.</u>				
If YES depth of formation _____				
Why _____				
Drillers Remarks: _____				

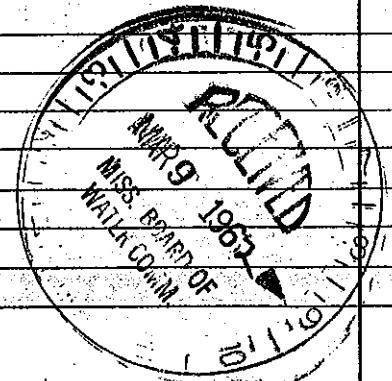

(Use Back Side)

Well No.

Mail this copy to Board of Water Commissioners 429 Miss. St. Jackson, Miss.