


BENTON MISSISSIPPI BOARD OF WATER COMMISSIONERS

H 2008

2-28-62 WATER WELL DRILLERS LOG

Date: 2-28, 19 62, Driller: Robert W. Wilson County Benton
(Name)

(1) Owner of Land: <u>Glyde Hudspeth</u> <small>(Name)</small>	Description & Color of Materials Sand, Clay, Red Clay, Shell, etc.	Thick- ness Feet	Depth Feet
<u>Ashland, Miss</u> <small>(Address)</small>	<u>Red Clay</u>	<u>20</u>	<u>0-2</u>
(2) Location: <u>1/4</u> , <u>1/4</u> , Sec. <u>T</u> , <u>R</u>	<u>Red Sand</u>	<u>50</u>	<u>20-7</u>
<u>1</u> miles <u>S</u> , of <u>Ashland</u> <small>(distance) (direction) (Nearest Town)</small>	<u>White Clay</u>	<u>20</u>	<u>20-</u>
(3) Topography: <u>Flat</u> <small>(Hilly) (Flat) (Level)</small>	<u>White Sand</u>	<u>50</u>	<u>20-</u>
(4) Purpose of Well: <u>Home</u> <small>(Domestic Irrigation Municipal, Industrial, Other)</small>			
Information upon completion of well:			
(1) Diameter <u>4</u> inches.			
(2) Total Depth <u>147</u> feet.			
(3) Water Level <u>120'</u> feet below top of ground.			
(4) Cased to <u>147</u> , Size <u>4"</u>			
(5) Screen: Size <u>4"</u> , Length <u>6'</u>			
(6) Were any formations sealed against pollution? <u>X</u> yes, <u>X</u> no.			
If YES, depth of formation _____			
Why _____			
Drillers Remarks: _____			

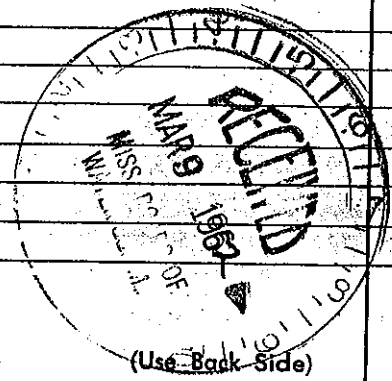

Well No.

Mail this copy to Board of Water Commissioners 429 Miss. St. Jackson, Miss.