

BENTON MISSISSIPPI BOARD OF WATER COMMISSIONERS

H 2009
5-11-62

WATER WELL DRILLERS LOG

Date: May 11, 1962, Driller: Robert W. Wilson County Benton
(Name)

(1) Owner of Land: <u>Mrs. E. D. Thompson</u> (Name)	Description & Color of Materials Sand, Clay, Red Clay, Shell, etc.	Thick- ness Feet	Depth Feet
<u>Ashland, Miss.</u> (Address)	<u>Red Sand</u>	<u>60</u>	<u>0-60</u>
(2) Location: <u>1/4</u> , <u>1/4</u> , Sec. <u>T</u> <u>R</u>	<u>White Clay</u>	<u>20</u>	<u>60-80</u>
<u>1</u> miles <u>N</u> , of <u>Ashland</u> (distance) (direction) (Nearest Town)	<u>White Sand</u>	<u>80</u>	<u>80-160</u>
(3) Topography: <u>X</u> (Hilly) (Flat) (Level)			
(4) Purpose of Well: <u>Home</u> (Domestic Irrigation Municipal, Industrial, Other)			


Information upon completion of well:

- (1) Diameter 4 inches.
- (2) Total Depth 160' feet.
- (3) Water Level 80' feet below top of ground.
- (4) Cased to 160', Size 4"
- (5) Screen: Size 4", Length 6'
- (6) Were any formations sealed against pollution?
_____ yes, X no.

If YES depth of formation _____

Why _____

Drillers Remarks: _____

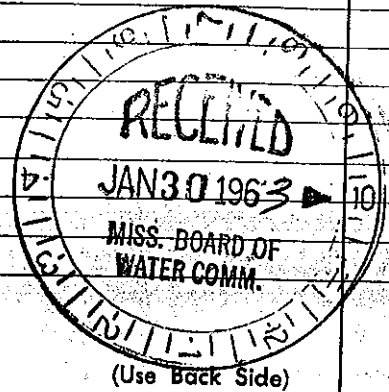

Well No.

Mail this copy to Board of Water Commissioners 429 Miss. St. Jackson, Miss