


BENTON MISSISSIPPI BOARD OF WATER COMMISSIONERS

H 2011
5-25-62

WATER WELL DRILLERS LOG

Date: May 25, 1962, Driller: Robert W. Wilson County Benton
(Name)

(1) Owner of Land: <u>Dr. Gray</u> (Name)	Description & Color of Materials Sand, Clay, Red Clay, Shell, etc.	Thick- ness Feet	Depth Feet
<u>Ashland, Miss.</u> (Address)	White Sand		
(2) Location: <u>1/4</u> , <u>1/4</u> , Sec. <u>T. R.</u>	<u>Red Sand</u>	<u>60'</u>	<u>0-60</u>
<u>3</u> miles <u>N.E.</u> , of <u>Ashland</u> (distance) (direction) (Nearest Town)	<u>White Clay</u>	<u>20'</u>	<u>60-80</u>
(3) Topography: <u>X</u> (Hilly) (Flat) (Level)	<u>White Sand</u>	<u>15'</u>	<u>80-125</u>
(4) Purpose of Well: <u>Home</u> (Domestic Irrigation Municipal, Industrial, Other)			
Information upon completion of well:			
(1) Diameter <u>4</u> inches.			
(2) Total Depth <u>125</u> feet.			
(3) Water Level <u>80'</u> feet below top of ground.			
(4) Cased to <u>125'</u> , Size <u>4"</u>			
(5) Screen: Size <u>4"</u> , Length <u>6'</u>			
(6) Were any formations sealed against pollution?			
<u>no</u> , <u>X</u> yes.			
If YES depth of formation _____			
Why _____			
Drillers Remarks: _____			

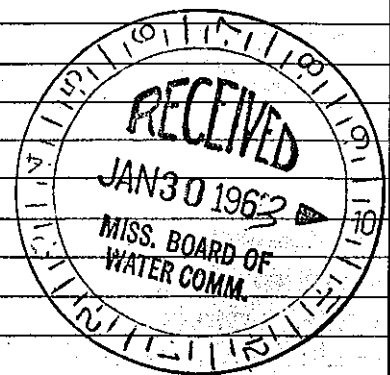

(Use Back Side)

Well No.

Mail this copy to Board of Water Commissioners 429 Miss. St. Jackson, Miss