


BENTON MISSISSIPPI BOARD OF WATER COMMISSIONERS

H 2013  
9-4-62

WATER WELL DRILLERS LOG

Date: Sept. 4, 1962 Driller: Robert W. Wilson County Benton  
(Name)

(1) Owner of Land: <u>Benton Co. Board of Education</u> (Name)	Description & Color of Materials Sand, Clay, Red Clay, Shell, etc.	Thick- ness Feet	Depth Feet
<u>Ashland, Miss</u>	<u>Red Sand</u>	<u>40</u>	<u>0-40</u>
<u>Old Salem School</u> (Address)	<u>White Sand</u>	<u>80</u>	<u>40-122</u>
(2) Location: <u>1/4, 1/4, Sec. T. R.</u>			
<u>3</u> miles <u>N.W.</u> of <u>Ashland</u> (distance) (direction) (Nearest Town)			
(3) Topography: <u>X</u> (Hilly) (Flat) (Level)			
(4) Purpose of Well: <u>School</u> (Domestic Irrigation Municipal, Industrial, Other)			
Information upon completion of well:			
(1) Diameter <u>4</u> inches.			
(2) Total Depth <u>122</u> feet.			
(3) Water Level <u>80'</u> feet below top of ground.			
(4) Cased to <u>122</u> , Size <u>4</u>			
(5) Screen: Size <u>4</u> , Length <u>6"</u>			
(6) Were any formations sealed against pollution?			
<u>no</u>			
If YES depth of formation _____			
Why _____			
Drillers Remarks: _____			
_____			
_____			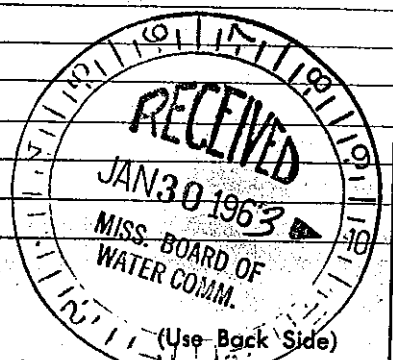
Well No.

Mail this copy to Board of Water Commissioners 429 Miss. St. Jackson, Miss