

BENTON MISSISSIPPI BOARD OF WATER COMMISSIONERS

H 2014


WATER WELL DRILLERS LOG

10-20-62

Date: Oct 20, 1962, Driller: Robert W. Wilson County Benton

(Name)

	Description & Color of Materials Sand, Clay, Red Clay, Shell, etc.	Thick- ness Feet	Depth Feet
(1) Owner of Land: <u>Luway Spraggberry</u> (Name) <u>Ashland Miss</u> (Address)	<u>Red Sand</u>	<u>30</u>	<u>0-30</u>
	<u>White Sand</u>	<u>120'</u>	<u>30-150</u>
(2) Location: <u>1/4</u> , <u>1/4</u> , Sec. <u>T</u> <u>R</u>			
<u>3</u> miles <u>S</u> of <u>Fishland</u> (distance) (direction) (Nearest Town)			
(3) Topography: <u>X</u> (Hilly) (Flat) (Level)			
(4) Purpose of Well: <u>Home</u> (Domestic Irrigation Municipal, Industrial, Other)			
Information upon completion of well:			
(1) Diameter <u>4</u> inches.			
(2) Total Depth <u>159</u> feet.			
(3) Water Level <u>12'</u> feet below top of ground.			
(4) Cased to <u>159'</u> , Size <u>4"</u>			
(5) Screen: Size <u>4"</u> , Length <u>6'</u>			
(6) Were any formations sealed against pollution? <u>no</u>			
If YES depth of formation _____			
Why _____			
Drillers Remarks: _____			
_____			
_____			
_____			

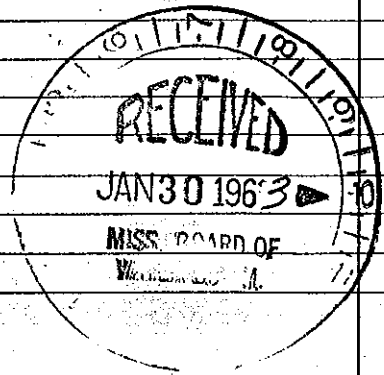

(Use Back Side)

Well No.

Mail this copy to Board of Water Commissioners 429 Miss. St. Jackson, Miss