

BENTON MISSISSIPPI BOARD OF WATER COMMISSIONERS

H 2015
10-26-62

WATER WELL DRILLERS LOG

Date: Oct 26, 1962, Driller: Robert W. Wilson County Benton
(Name)

		Description & Color of Materials Sand, Clay, Red Clay, Shell, etc.	Thick- ness Feet	Depth Feet
(1) Owner of Land: <u>Edison Elliotte</u> (Name)				
<u>Ashland, Miss</u> (Address)		<u>Red Sand</u>	<u>30</u>	<u>0-30</u>
		<u>White Sand</u>	<u>104</u>	<u>30-134</u>
(2) Location: <u>1/4</u> , <u>1/4</u> , Sec. <u>T</u> <u>R</u>				
<u>5</u> miles <u>S</u> , of <u>Ashland</u> (distance) (direction) (Nearest Town)				
(3) Topography: <u>X</u> (Hilly) (Flat) (Level)				
(4) Purpose of Well: <u>Home</u> (Domestic Irrigation Municipal, Industrial, Other)				


Information upon completion of well:

- (1) Diameter 4 inches.
- (2) Total Depth 134 feet.
- (3) Water Level 100' feet below top of ground.
- (4) Cased to 134, Size 4.
- (5) Screen: Size 1/4, Length 6'.
- (6) Were any formations sealed against pollution?
_____ yes, 1 no.

If YES depth of formation _____

Why _____

Drillers Remarks: _____

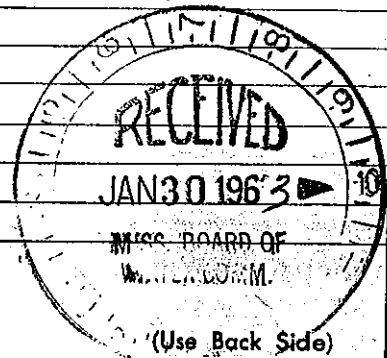

Well No.

Mail this copy to Board of Water Commissioners 429 Miss. St. Jackson, Miss