

BENTON MISSISSIPPI BOARD OF WATER COMMISSIONERS


H 2014
1-2-63

WATER WELL DRILLERS LOG

Date: Jan 2, 1963, Driller: Robert W. Wilson County _____

(Name)

(1) Owner of Land: <u>Fletcher Akin</u> (Name)	Description & Color of Materials Sand, Clay, Red Clay, Shell, etc.	Thick- ness Feet	Depth Feet
<u>Ashland, Miss</u> (Address)	<u>Red Sand</u>	<u>20'</u>	<u>0-20</u>
(2) Location: _____ 1/4, _____ 1/4, Sec. _____ T. R. _____	<u>White Sand</u>	<u>55</u>	<u>20-75</u>
<u>3</u> miles <u>N.W.</u> , of <u>Ashland</u> (distance) (direction) (Nearest Town)			
(3) Topography: _____ (Hilly) (Flat) (Level) <u>X</u>			
(4) Purpose of Well: <u>Home</u> (Domestic Irrigation, Municipal, Industrial, Other)			
Information upon completion of well:			
(1) Diameter <u>4"</u> inches.			
(2) Total Depth <u>75</u> feet.			
(3) Water Level <u>50'</u> feet below top of ground.			
(4) Cased to <u>75'</u> , Size <u>4"</u>			
(5) Screen: Size <u>4"</u> , Length <u>6'</u>			
(6) Were any formations sealed against pollution?			
_____ yes, <u>X</u> no.			
If YES depth of formation _____			
Why _____			
Drillers Remarks: _____			

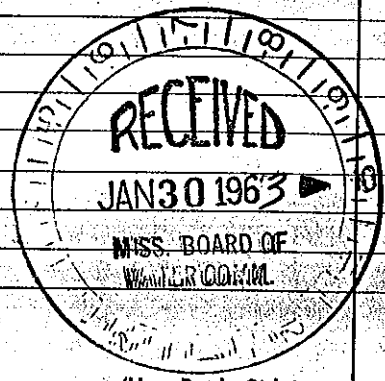

Well No.

Mail this copy to Board of Water Commissioners 429 Miss. St. Jackson, Miss