

BENTON MISSISSIPPI BOARD OF WATER COMMISSIONERS

H 2017


WATER WELL DRILLERS LOG

8-22-63

Date: Aug 22, 1963, Driller: Robert W. Wilson, County Benton

(Name)

		Description & Color of Materials Sand, Clay, Red Clay, Shell, etc.	Thick- ness Feet	Depth Feet
(1) Owner of Land: <u>Bobby Jordan</u> (Name)		<u>Red clay</u>	<u>8</u>	<u>0-8</u>
<u>Ashland</u> (Address)		<u>" sand</u>	<u>42</u>	<u>8-50</u>
(2) Location: <u>1/4</u> , <u>1/4</u> , Sec. <u>T</u> <u>R</u>		<u>White clay</u>	<u>165</u>	<u>50-16</u>
<u>3</u> miles <u>W</u> , of <u>Ashland</u> (distance) (direction) (Nearest Town)				
(3) Topography: <u>X</u> (Hilly) (Flat) (Level)				
(4) Purpose of Well: <u>Home</u> (Domestic Irrigation Municipal, Industrial, Other)				
Information upon completion of well:				
(1) Diameter <u>4</u> inches.				
(2) Total Depth <u>165</u> feet.				
(3) Water Level <u>130</u> feet below top of ground.				
(4) Cased to <u>165</u> , Size <u>4</u>				
(5) Screen: Size <u>4</u> , Length <u>6</u>				
(6) Were any formations sealed against pollution? <u>no</u> yes, <u>X</u> no.				
If YES depth of formation _____				
Why _____				
Drillers Remarks: _____				

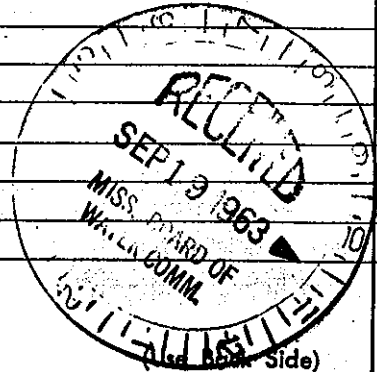

Well No.

Mail this copy to Board of Water Commissioners 429 Miss. St. Jackson, Miss.