


BENTON MISSISSIPPI BOARD OF WATER COMMISSIONERS

H 2018
8-26-63

WATER WELL DRILLERS LOG

Date: Aug 26, 1963, Driller: Robert W. Wilson County Benton
(Name)

(1) Owner of Land: <u>Mrs. Treadwell Aldrich</u> (Name)	Description & Color of Materials Sand, Clay, Red Clay, Shell, etc.	Thick- ness Feet	Depth Feet
<u>Michigan City</u> (Address)	<u>Red dirt</u>	<u>15</u>	<u>0-15</u>
(2) Location: <u>1/4</u> , <u>1/4</u> , Sec. <u>T R</u>	<u>" sand</u>	<u>15</u>	<u>15-30</u>
<u>1/2</u> miles <u>of Ashland</u> (distance) (direction) (Nearest Town)	<u>White clay</u>	<u>10</u>	<u>30-40</u>
(3) Topography: <u>X</u> (Hilly) (Flat) (Level)	<u>" Sand</u>	<u>25</u>	<u>40-65</u>
(4) Purpose of Well: <u>Home</u> (Domestic Irrigation Municipal, Industrial, Other)			
Information upon completion of well:			
(1) Diameter <u>4</u> inches.			
(2) Total Depth <u>65</u> feet.			
(3) Water Level <u>45</u> feet below top of ground.			
(4) Cased to <u>65</u> , Size <u>4</u>			
(5) Screen: Size <u>4</u> , Length <u>6</u>			
(6) Were any formations sealed against pollution? <u>no</u>			
If YES depth of formation _____			
Why _____			
Drillers Remarks: _____			

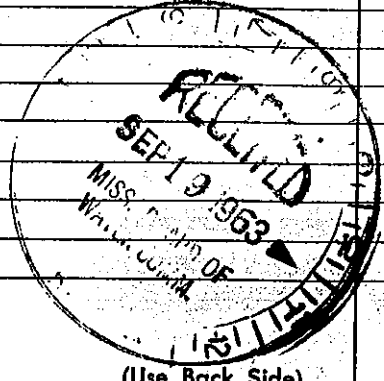

(Use Back Side)

Well No.

Mail this copy to Board of Water Commissioners 429 Miss. St. Jackson, Miss.