

BENTON MISSISSIPPI BOARD OF WATER COMMISSIONERS

H 2019
8-30-63


WATER WELL DRILLERS LOG

6

Date: Aug 30, 1963, Driller: Robert W. Wilson County Benton

(Name)

	Description & Color of Materials Sand, Clay, Red Clay, Shell, etc.	Thick- ness Feet	Depth Feet
(1) Owner of Land: <u>W. E. Atkins</u> (Name)	<u>Red Clay</u>	<u>10</u>	<u>0-10</u>
<u>Ashland, Miss</u> (Address)	<u>" Sand</u>	<u>30</u>	<u>10-40</u>
(2) Location: <u>1/4</u> , <u>1/4</u> , Sec. <u> </u> T. <u> </u> R. <u> </u>	<u>White Sand</u>	<u>65</u>	<u>40-70</u>
<u>2</u> miles <u>N.W.</u> of <u>Ashland</u> (distance) (direction) (Nearest Town)			
(3) Topography: <u>A</u> (Hilly) (Flat) (Level)			
(4) Purpose of Well: <u>Home</u> (Domestic, Irrigation, Municipal, Industrial, Other)			
Information upon completion of well:			
(1) Diameter <u>4</u> inches.			
(2) Total Depth <u>105</u> feet.			
(3) Water Level <u>85</u> feet below top of ground.			
(4) Cased to <u>105</u> , Size <u>4</u>			
(5) Screen: Size <u>4</u> , Length <u>6</u>			
(6) Were any formations sealed against pollution?			
<u> </u> yes, <u>1</u> no.			
If YES depth of formation			
Why			
Drillers Remarks:			

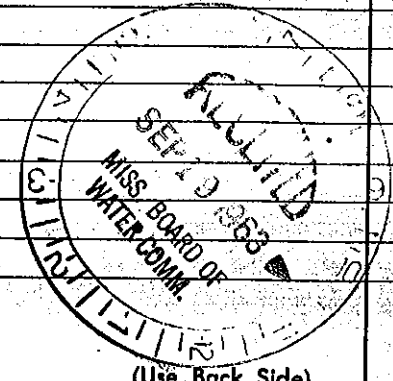

(Use Back Side)

Well No.

Mail this copy to Board of Water Commissioners 429 Miss. St. Jackson, Miss.