

BENTON MISSISSIPPI BOARD OF WATER COMMISSIONERS

H 2020  
9-17-63

WATER WELL DRILLERS LOG

19

Date: Sept. 17, 1963, Driller: R.W. Wilson County Benton

OTB White Bluffs, Tenn.

(1) Owner of Land: <u>Joe Hicks</u> <small>(Name)</small>	Description & Color of Materials Sand, Clay, Red Clay, Shell, etc.	Thick- ness Feet	Depth Feet
<u>Ashland, Miss</u> <small>(Address)</small>	<u>Red sand</u>	<u>40</u>	<u>0-40</u>
	<u>White clay</u>		<u>40-55</u>
	<u>Red sand</u>		<u>55-105</u>
	<u>White sand</u>		<u>105-A</u>
(2) Location: <u>1/4</u> , <u>1/4</u> , Sec. <u>T</u> <u>R</u> ,  <u>_____</u> miles <u>_____</u> of <u>_____</u> <small>(distance) (direction) (Nearest Town)</small>			
(3) Topography: <u>_____</u> <small>(Hilly) (Flat) (Level)</small>			
(4) Purpose of Well: <u>Domestic</u> <small>(Domestic Irrigation Municipal, Industrial, Other)</small>			


Information upon completion of well:

- (1) Diameter 4 inches.
- (2) Total Depth 151 feet.
- (3) Water Level \_\_\_\_\_ feet below top of ground.
- (4) Cased to 151, Size 4"
- (5) Screen: Size 4", Length 6
- (6) Were any formations sealed against pollution?  
\_\_\_\_\_ yes, X no.

If YES depth of formation \_\_\_\_\_

Why \_\_\_\_\_

Drillers Remarks: \_\_\_\_\_

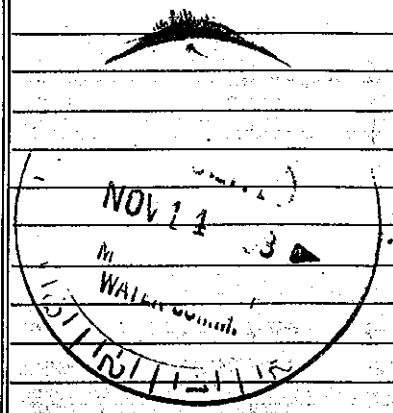

(Use Back Side)

Well No.

Mail this copy to Board of Water Commissioners 429 Miss. St. Jackson, Miss.