

BENTON WATER WELL DRILLERS LOG

Date: 10-3-63, 1963, Driller: P. W. Wilson County Benton

(Name)

(1) Owner of Land: Tandy Hoover
 (Name)
Ashland
 (Address)

(2) Location: 1/4, 1/4, Sec. T R,
 miles of
 (distance) (direction) (Nearest Town)

(3) Topography:
 (Hilly) (Flat) (Level)

(4) Purpose of Well: Domestic
 (Domestic Irrigation
 Municipal, Industrial, Other)

| Description & Color of Materials Sand, Clay, Red Clay, Shell, etc. | Thick- ness Feet | Dept Feet |
|---|------------------------|--------------|
| Red Sand | 20 | 0-2 |
| " " & white clay | 20 | 20-4 |
| White Sand | 110 | 40-6 |
| | | |
| | | |
Information upon completion of well:

(1) Diameter 4 inches.

(2) Total Depth 150 feet.

(3) Water Level feet below top of ground.

(4) Cased to 150, Size 4


(5) Screen: Size 4, Length 6

(6) Were any formations sealed against pollution?
 yes, X no.

If YES depth of formation

Why

Drillers Remarks:

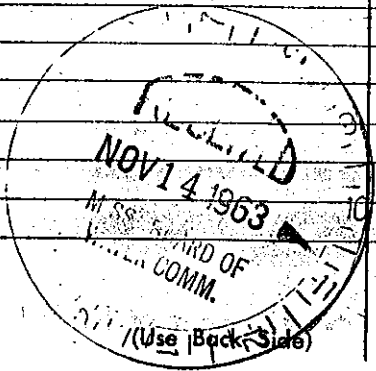

Retain this copy for your office files.

Well No.