

BENTON MISSISSIPPI BOARD OF WATER COMMISSIONERS

H 2023
10-4-63

WATER WELL DRILLERS LOG

Date: Oct. 4, 1963, Driller: R. W. Wilson County Benton
(Name)

(1) Owner of Land: <u>G. P. Harrison Jr. +</u> (Name) <u>George Little</u> <u>Ashland, Miss</u> (Address)	Description & Color of Materials Sand, Clay, Red Clay, Shell, etc.	Thick- ness Feet	Depth Feet
	Red Dirt	15	0-15
	" Sand	50	15-6
	Hard Sand rock	1	65-66
	Red Sand	15	66-8
	Hard Rock	2	81-82
	White Sand & clay	30	83-11
	Hard rock	6	113-115
	Red Sand	35	119-15
	White "	34	154-18

(2) Location: 1/4, 1/4, Sec. T. R.
miles of miles of miles of
(distance) (direction) (Nearest Town)

(3) Topography: (Hilly) (Flat) (Level)

(4) Purpose of Well: Domestic
(Domestic Irrigation, Municipal, Industrial, Other)

Information upon completion of well:

(1) Diameter 4 inches.

(2) Total Depth 188 feet.

(3) Water Level feet below top of ground.

(4) Cased to 188, Size 4


(5) Screen: Size 4, Length 6

(6) Were any formations sealed against pollution?
 yes, X no.

If YES depth of formation

Why

Drillers Remarks:

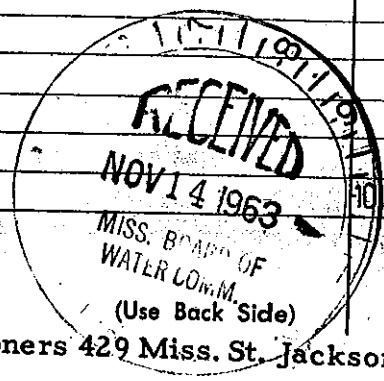

Mail this copy to Board of Water Commissioners 429 Miss. St. Jackson, Miss.

Well No.