

BENTON MISSISSIPPI BOARD OF WATER COMMISSIONERS

H 2094

WATER WELL DRILLERS LOG

10-24-63

Date: 10-24, 1963, Driller: R. W. Wilson County Benton

(Name)

| (1) Owner of Land: <u>E.A. Griffin</u> (Name) | Description & Color of Materials Sand, Clay, Red Clay, Shell, etc. | Thick- ness Feet | Depth Feet |
|---|---|------------------------|----------------|
| <u>Ashland, Miss.</u> (Address) | <u>Red Sand</u> | <u>130</u> | <u>0-130</u> |
| (2) Location: _____ 1/4, _____ 1/4, Sec. _____ T. R. _____ | <u>White "</u> | <u>40</u> | <u>130-170</u> |
| _____ miles _____ of _____ (distance) (direction) (Nearest Town) | | | |
| (3) Topography: _____ (Hilly) (Flat) (Level) | | | |
| (4) Purpose of Well: <u>Domestic</u> (Domestic Irrigation Municipal, Industrial, Other) | | | |


Information upon completion of well:

- (1) Diameter 4 inches.
- (2) Total Depth 170 feet.
- (3) Water Level 150 feet below top of ground.
- (4) Cased to 170', Size 4"
- (5) Screen: Size 4", Length 6'
- (6) Were any formations sealed against pollution?
_____ yes, X no.

If YES depth of formation _____

Why _____

Drillers Remarks: _____

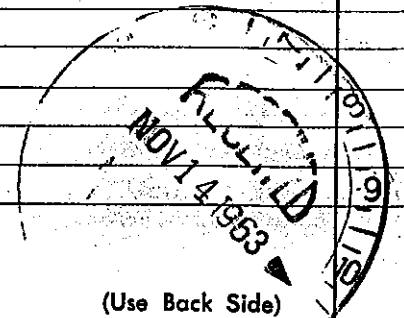

(Use Back Side)

Well No.

Mail this copy to Board of Water Commissioners 429 Miss. St. Jackson, Miss.