

BENTON MISSISSIPPI BOARD OF WATER COMMISSIONERS

H 2085
11-4-63

WATER WELL DRILLERS LOG

Date: 11-4, 1963, Driller: Robert W. Wilson County: Benton

(Name)

(1) Owner of Land: (Name) Ashland, Miss. (Address)	Description & Color of Materials Sand, Clay, Red Clay, Shell, etc.	Thick- ness Feet	Depth Feet
	white clay	20	0-20
	" Sand & clay	20	20-40
	" "	20	40-60
(2) Location: 1/4, 1/4, Sec. T R	Brows "	30	60-90
4 miles SOUTH of Ashland, (distance) (direction) (Nearest Town)	Black Clay	30	90-120
(3) Topography: (Hilly) (Flat) (Level)	Blue " + Sand	20	120-140
(4) Purpose of Well: Domestic (Domestic Irrigation Municipal, Industrial, Other)	" " + ROCK	10	140-150
	white sand	14	150-164


Information upon completion of well:

- (1) Diameter 4 inches.
- (2) Total Depth 164 feet.
- (3) Water Level 70 feet below top of ground.
- (4) Cased to 164, Size 4"
- (5) Screen: Size 4"; Length 6'
- (6) Were any formations sealed against pollution?
yes, no.

If YES depth of formation _____

Why _____

Drillers Remarks: _____

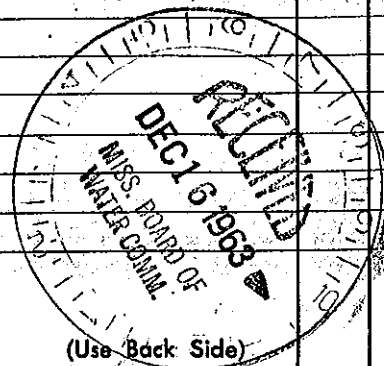

Well No.

Mail this copy to Board of Water Commissioners 429 Miss. St. Jackson, Miss.