

BENTON MISSISSIPPI BOARD OF WATER COMMISSIONERS

H 2026

WATER WELL DRILLERS LOG

11-7-63

Date: 11-7, 1963, Driller: Robert Wilson County: Benton (Name)

(1) Owner of Land (Name)	Description & Color of Materials Sand, Clay, Red Clay, Shell, etc.	Thick- ness Feet	Depth Feet
(3) Topography: (Hilly) (Flat) (Level)			
(4) Purpose of Well: Domestic (Domestic Irrigation Municipal, Industrial, Other)			


Information upon completion of well:

- (1) Diameter 4 inches.
- (2) Total Depth 127 feet.
- (3) Water Level 105 feet below top of ground.
- (4) Cased to 127, Size 4"
- (5) Screen: Size 4", Length 6'
- (6) Were any formations sealed against pollution?
 yes, no.

If YES depth of formation _____

Why _____

Drillers Remarks: _____

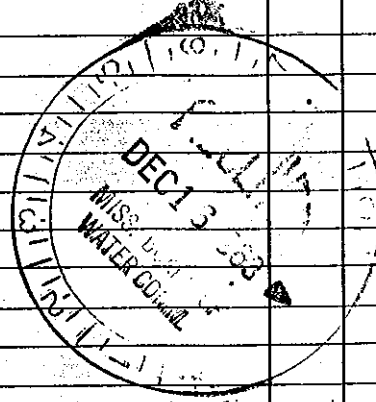

(Use Back Side)

Well No.

Mail this copy to Board of Water Commissioners 429 Miss. St. Jackson, Miss.