


BENTON MISSISSIPPI BOARD OF WATER COMMISSIONERS

H 2028
1-13-64

WATER WELL DRILLERS LOG

Date: 1-13, 1964, Driller: Robert W. Wilson County Benton
(Name)

(1) Owner of Land	Description & Color of Materials Sand, Clay, Red Clay, Shell, etc.	Thick- ness Feet	Depth Feet
<u>Lester Holbrook</u> (Name)	<u>Red dirt</u>	<u>20</u>	<u>0-20</u>
<u>Asbland</u> (Address)	<u>" Sand</u>	<u>90</u>	<u>20-110</u>
(2) Location: <u>1/4</u> , <u>1/4</u> , Sec. <u> </u> T. <u>R</u>	<u>" " & clay</u>	<u>10</u>	<u>110-120</u>
<u> </u> miles <u> </u> of <u> </u> (distance) (direction) (Nearest Town)	<u>white "</u>	<u>20</u>	<u>120-140</u>
(3) Topography: <u> </u> (Hilly) (Flat) (Level)	<u>" " "</u>	<u>10</u>	<u>140-150</u>
(4) Purpose of Well: <u>Domestic</u> (Domestic Irrigation Municipal, Industrial, Other)	<u>" " "</u>	<u>21</u>	<u>150-171</u>
Information upon completion of well:			
(1) Diameter <u>4</u> inches.			
(2) Total Depth <u>171</u> feet.			
(3) Water Level <u>130</u> feet below top of ground.			
(4) Cased to <u>171</u> , Size <u>4"</u>			
(5) Screen: Size <u>4"</u> , Length <u>6'</u>			
(6) Were any formations sealed against pollution?			
<u> </u> yes, <u>X</u> no.			
If YES depth of formation <u> </u>			
Why <u> </u>			
Drillers Remarks: <u> </u>			
<u> </u>			
<u> </u>			
<u> </u>			
<u> </u>			

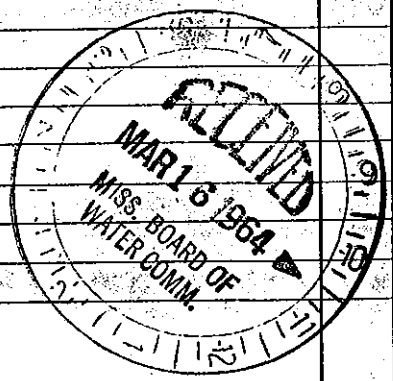

(Use Back Side)

Well No.

Mail this copy to Board of Water Commissioners 429 Miss. St. Jackson, Miss.