

BENTON MISSISSIPPI BOARD OF WATER COMMISSIONERS

H 20 29

WATER WELL DRILLERS LOG

2-24-64

Date: 2-24- 1964, Driller: Robert W. Wilson County Benton
(Name)

(1) Owner of Land: <u>W. E. Atkins</u> (Name)	Description & Color of Materials Sand, Clay, Red Clay, Shell, etc.	Thick- ness Feet	Depth Feet
<u>Ashtland, Miss</u> (Address)	<u>Red Clay</u>	<u>0-15</u>	<u>15</u>
(2) Location: <u>1/4</u> , <u>1/4</u> , Sec. <u>T</u> <u>R</u>	<u>Red Sand-White Clay</u>	<u>15-25</u>	<u>25</u>
<u>2</u> miles <u>N</u> of <u>Ashtland</u> (distance) (direction) (Nearest Town)	<u>White</u>	<u>25-35</u>	<u>35</u>
(3) Topography: <u>X</u> (Hilly) (Flat) (Level)	<u>Red Sand</u>	<u>35-45</u>	<u>45</u>
(4) Purpose of Well: <u>Home</u> (Domestic Irrigation Municipal, Industrial, Other)	<u>White</u>	<u>45-55</u>	<u>55</u>
	<u>"</u>	<u>55-65</u>	<u>65</u>
	<u>"</u>	<u>65-75</u>	<u>75</u>
	<u>"</u>	<u>75-83</u>	<u>83</u>


Information upon completion of well:

- (1) Diameter 4 inches.
- (2) Total Depth 83 feet.
- (3) Water Level 60 feet below top of ground.
- (4) Cased to 83, Size 4
- (5) Screen: Size 4, Length 6'
- (6) Were any formations sealed against pollution?
_____ yes, _____ no.

If YES depth of formation _____

Why _____

Drillers Remarks: _____

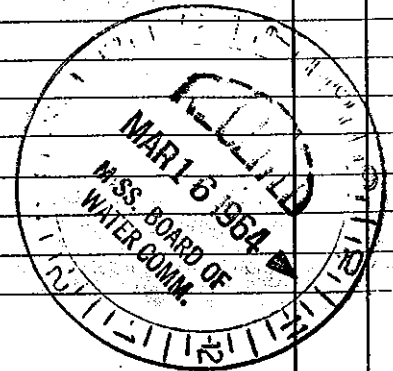

(Use Back Side)

Well No.

Mail this copy to Board of Water Commissioners 429 Miss. St. Jackson, Miss.