


BENTON MISSISSIPPI BOARD OF WATER COMMISSIONERS

H 2031
5-11-64

WATER WELL DRILLERS LOG

Date: 5-11-, 1964, Driller: Robert W. Wilson County Benton
(Name)

(1) Owner of Land: <u>LEE Childress</u> (Name)	Description & Color of Materials Sand, Clay, Red Clay, Shell, etc.	Thick- ness Feet	Depth Feet
<u>Asbland Miss.</u> (Address)	<u>Red clay</u>	<u>10</u>	<u>0-10</u>
(2) Location: <u>1/4</u> , <u>1/4</u> , Sec. <u>T</u> <u>R</u>	<u>Red sand</u>	<u>40</u>	<u>10-50</u>
<u>1/4</u> miles, of <u>Asbland</u> (distance) (direction) (Nearest Town)	<u>White sand + clay mix</u>	<u>10</u>	<u>50-60</u>
(3) Topography: <u>X</u> (Hilly) (Flat) (Level)	" "		<u>60-91</u>
(4) Purpose of Well: <u>Domestic</u> (Domestic Irrigation Municipal, Industrial, Other)			
Information upon completion of well:			
(1) Diameter <u>4</u> inches.			
(2) Total Depth <u>91</u> feet.			
(3) Water Level <u>60</u> feet below top of ground.			
(4) Cased to <u>57</u> , Size <u>4"</u>			
(5) Screen: Size <u>6"</u> , Length <u>4'</u>			
(6) Were any formations sealed against pollution?			
<u> </u> yes, <u>X</u> no.			
If YES depth of formation _____			
Why _____			
Drillers Remarks: _____			

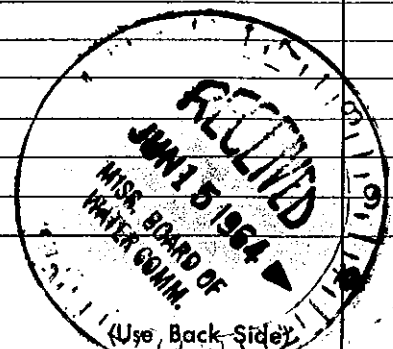

Well No.

Mail this copy to Board of Water Commissioners 429 Miss. St. Jackson, Miss.