

BENTON MISSISSIPPI BOARD OF WATER COMMISSIONERS


H 2032

6-18-64

WATER WELL DRILLERS LOG

Date: 6-18, 1964, Driller: Robert White ~~Harvey Skelton~~ County Benton  
(Name)

(1) Owner of Land: <u>Harvey Skelton</u> <small>(Name)</small>	Description & Color of Materials Sand, Clay, Red Clay, Shell, etc.	Thick- ness Feet	Depth Feet
<u>Lamar</u> <small>(Address)</small>	<u>Red dirt</u>	<u>0</u>	<u>10</u>
	<u>" sand</u>	<u>10</u>	<u>80</u>
(2) Location: <u>1/4</u> , <u>1/4</u> , Sec. <u>T R</u> ,	<u>white "</u>	<u>80</u>	<u>90</u>
<u>4</u> miles <u>W</u> , of <u>Ashland</u>	<u>" clay</u>	<u>90</u>	<u>100</u>
<small>(distance) (direction) (Nearest Town)</small>	<u>" sand</u>	<u>100</u>	<u>130</u>
(3) Topography: <input checked="" type="checkbox"/> (Hilly) <input type="checkbox"/> (Flat) <input type="checkbox"/> (Level)			
(4) Purpose of Well: <u>Domestic</u>			
<small>(Domestic Irrigation Municipal, Industrial, Other)</small>			
Information upon completion of well:			
(1) Diameter <u>4</u> inches.			
(2) Total Depth <u>130</u> feet.			
(3) Water Level <u>100</u> feet below top of ground.			
(4) Cased to <u>130</u> , Size <u>4</u>			
(5) Screen: Size <u>6</u> , Length <u>4</u>			
(6) Were any formations sealed against pollution?			
<u>no</u>			
If YES depth of formation _____			
Why _____			
Drillers Remarks: _____			
_____			
_____			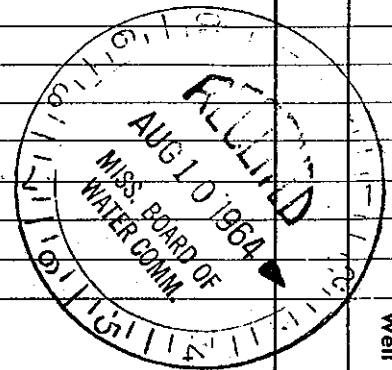
(Use Back Side)

Well No.

Mail this copy to Board of Water Commissioners 429 Miss. St. Jackson, Miss.