

BENTON MISSISSIPPI BOARD OF WATER COMMISSIONERS

H 2034

7-2-64

WATER WELL DRILLERS LOG

Date: 7-2, 1964, Driller: Robert W. Wilson County Benton

(Name)

(1) Owner of Land: <u>Niles Hobson</u> (Name)	Description & Color of Materials Sand, Clay, Red Clay, Shell, etc.	Thick- ness Feet	Depth Feet
<u>Ashland</u> (Address)	<u>Red dirt</u>	<u>0</u>	<u>20</u>
(2) Location: <u>1/4</u> , <u>1/4</u> , Sec. <u>T</u> <u>R</u>	<u>" sand</u>	<u>30</u>	<u>70</u>
<u>2</u> miles <u>W</u> of <u>Ashland</u> (distance) (direction) (Nearest Town)	<u>white " clay</u>	<u>70</u>	<u>90</u>
(3) Topography: <u>1</u> (Hilly) (Flat) (Level)	<u>Red sand</u>	<u>90</u>	<u>130</u>
(4) Purpose of Well: <u>Domestic</u> (Domestic Irrigation Municipal, Industrial, Other)	<u>white "</u>	<u>130</u>	<u>158</u>


Information upon completion of well:

- (1) Diameter 4 inches.
- (2) Total Depth 158 feet.
- (3) Water Level 125 feet below top of ground.
- (4) Cased to 158, Size 4
- (5) Screen: Size 4, Length 4 1/2
- (6) Were any formations sealed against pollution?
 yes, no.

If YES depth of formation _____

Why _____

Drillers Remarks: _____

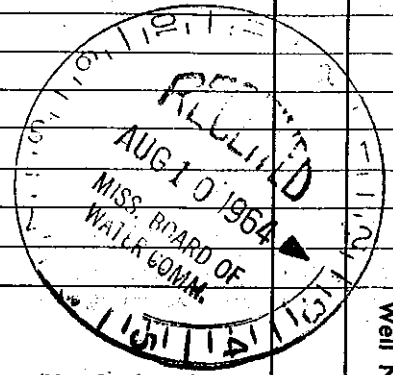

(Use Back Side)

Well No.

Mail this copy to Board of Water Commissioners 429 Miss. St. Jackson, Mis: