

BENTON MISSISSIPPI BOARD OF WATER COMMISSIONERS

H 2036
8-31-64

WATER WELL DRILLERS LOG

Date: Aug 31, 1964, Driller: Robert W. Wilson County Benton
(Name)

(1) Owner of Land: <u>J. L. Hobson</u> (Name)	Description & Color of Materials Sand, Clay, Red Clay, Shell, etc.	Thick- ness Feet	Depth Feet
<u>Ashland</u> (Address)	<u>Brown clay</u>	<u>10</u>	<u>10</u>
(2) Location: <u>1/4</u> , <u>1/4</u> , Sec. <u>T</u> <u>R</u>	<u>Red sand</u>	<u>20</u>	<u>30</u>
<u>2</u> miles <u>E</u> , of <u>Old Salem</u> <u>S</u> (distance) (direction) (Nearest Town)	<u>white " white clay</u>	<u>10</u>	<u>40</u>
(3) Topography: <u>X</u> (Hilly) (Flat) (Level)	<u>yellow sand</u>	<u>30</u>	<u>70</u>
(4) Purpose of Well: <u>Domestic</u> (Domestic Irrigation Municipal, Industrial, Other)	<u>White "</u>	<u>14</u>	<u>84</u>


Information upon completion of well:

- (1) Diameter 4 inches.
- (2) Total Depth 84 feet.
- (3) Water Level 40 feet below top of ground.
- (4) Cased to 84, Size 4
- (5) Screen: Size 6, Length 4
- (6) Were any formations sealed against pollution?
no

If YES depth of formation _____

Why _____

Drillers Remarks: _____

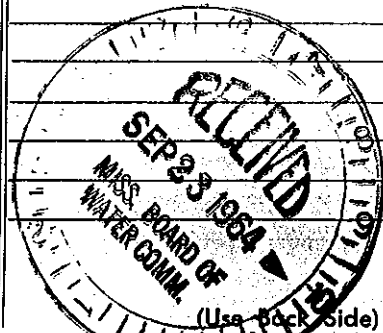

Well No.

Mail this copy to Board of Water Commissioners 229 Miss. St. Jackson, Miss.