


BENTON MISSISSIPPI BOARD OF WATER COMMISSIONERS

H 2039

11-27-64 WATER WELL DRILLERS LOG

Date: Nov. 27, 1964, Driller: Robert W. Wilson County Benton
(Name)

(1) Owner of Land: <u>W. T. Akin</u> <small>(Name)</small>	Description & Color of Materials Sand, Clay, Red Clay, Shell, etc.	Thick- ness Feet	Depth Feet
<u>Ashland</u> <small>(Address)</small>	<u>white clay</u>	<u>10</u>	<u>10</u>
(2) Location: <u>1/4</u> , <u>1/4</u> , Sec. <u>T R</u>	<u>Red Sand</u>	<u>60</u>	<u>70</u>
<u>3</u> miles <u>N</u> , of <u>Ashland</u> <small>(distance) (direction) (Nearest Town)</small>	<u>white sand</u>	<u>20</u>	<u>90</u>
(3) Topography: <u>fl</u> <small>(Hilly) (Flat) (Level)</small>	<u>Blue Sand</u>	<u>32</u>	<u>122</u>
(4) Purpose of Well: <u>Domestic</u> <small>(Domestic Irrigation Municipal, Industrial, Other)</small>			
Information upon completion of well:			
(1) Diameter <u>4</u> inches.			
(2) Total Depth <u>120</u> feet.			
(3) Water Level <u>90</u> feet below top of ground.			
(4) Cased to <u>120</u> , Size <u>4</u>			
(5) Screen: Size <u>4</u> , Length <u>6</u>			
(6) Were any formations sealed against pollution?			
<u>no</u> yes, <u>1</u> no.			
If YES depth of formation _____			
Why _____			
Drillers Remarks: _____			

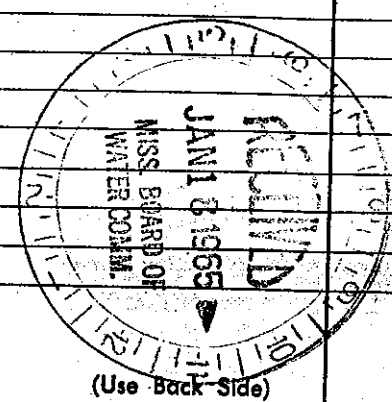

Mail this copy to Board of Water Commissioners 429 Miss. St. Jackson, Miss.

Well No. _____

(Use Back Side)