

**BENTON** MISSISSIPPI BOARD OF WATER COMMISSIONERS

**H2043**


**5-2-65**

**WATER WELL DRILLERS LOG**

Date: 5-2, 1965, Driller: ROBERT N. WILSON County BENTON

(Name)

(1) Owner of Land: <u>BUFORD SIMPSON</u> (Name)	Description & Color of Materials Sand, Clay, Red Clay, Shell, etc.	Thick- ness Feet	Depth Feet
<u>ASHLAND MISS</u> (Address)	<u>RED SAND</u>	<u>30</u>	<u>0-3</u>
(2) Location: <u>1/4</u> , <u>1/4</u> , Sec. <u>T</u> <u>R</u>	<u>CLAY</u>	<u>4</u>	<u>30-3</u>
<u>2</u> miles <u>SOUTH</u> , of <u>ASHLAND</u> , (distance) (direction) (Nearest Town)	<u>RED SAND</u>	<u>56</u>	<u>34-9</u>
(3) Topography: <u>HILLY</u> (Hilly) (Flat) (Level)	<u>WHITE SAND</u>	<u>20</u>	<u>90-1</u>
(4) Purpose of Well: <u>HOME</u> (Domestic Irrigation Municipal, Industrial, Other)	<u>CLAY</u>	<u>15</u>	<u>105-1</u>
	<u>SAND</u>	<u>12</u>	<u>121-1</u>
Information upon completion of well:			
(1) Diameter <u>4</u> inches.			
(2) Total Depth <u>137</u> feet.			
(3) Water Level <u>100</u> feet below top of ground.			
(4) Cased to <u>127</u> , Size <u>4"</u>			
(5) Screen: Size <u>6"</u> , Length <u>4'</u>			
(6) Were any formations sealed against pollution?			
<u>yes</u> , <u>X</u> no.			
If YES, depth of formation _____			
Why _____			
Drillers Remarks: _____			
_____			
_____			
_____			

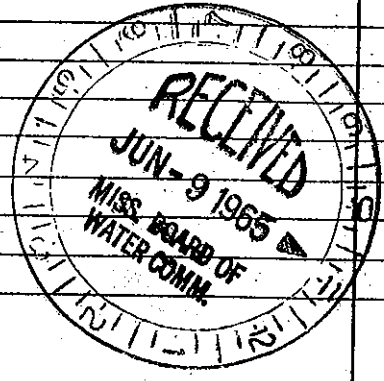

(Use Back Side)

Well No.

Mail this copy to Board of Water Commissioners 429 Miss. St. Jackson, Miss.