


BENTON MISSISSIPPI BOARD OF WATER COMMISSIONERS

H 2045  
7-13-65

WATER WELL DRILLERS LOG

Date: 7-13, 1965, Driller: ROBERT W. WILSON County BENTON  
(Name)

(1) Owner of Land: <u>J.H. SKELTON</u> (Name)	Description & Color of Materials Sand, Clay, Red Clay, Shell, etc.	Thick- ness Feet	Depth Feet
<u>LAMAR, TENN.</u> (Address)	<u>Red dirt</u>	<u>10</u>	<u>0-10</u>
(2) Location: <u>1/4, 1/4, Sec. T R</u> <u>ASHLAND</u>	<u>Red sand</u>		<u>10-60</u>
<u>3</u> miles <u>West</u> , of <u>ASHLAND</u> (distance) (direction) (Nearest Town)	<u>White sand</u>		<u>60-100</u>
(3) Topography: <input checked="" type="checkbox"/> (Hilly) <input type="checkbox"/> (Flat) <input type="checkbox"/> (Level)			
(4) Purpose of Well: <u>Domestic</u> (Domestic Irrigation, Municipal, Industrial, Other)			
Information upon completion of well:			
(1) Diameter <u>4</u> inches.			
(2) Total Depth <u>129</u> feet.			
(3) Water Level <u>90</u> feet below top of ground.			
(4) Cased to <u>129</u> , Size <u>4"</u>			
(5) Screen: Size <u>6"</u> , Length <u>4'</u>			
(6) Were any formations sealed against pollution? <u>yes</u> , <input checked="" type="checkbox"/> <u>no</u> , <input type="checkbox"/>			
If YES, depth of formation _____			
Why _____			
Drillers Remarks: _____			

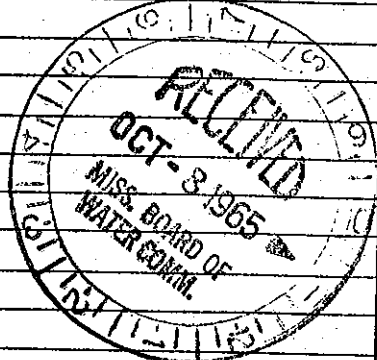

(Use Back Side)

Well No.

Mail this copy to Board of Water Commissioners 429 Miss. St. Jackson, Miss.