

**BENTON** MISSISSIPPI BOARD OF WATER COMMISSIONERS

H 2046


7-23-65

**WATER WELL DRILLERS LOG**

Date: 7-23, 1965, Driller: Robert W. Wilson County BENTON

(Name)

(1) Owner of Land: <u>JIMMIE WILLIFORD</u> (Name)	Description & Color of Materials Sand, Clay, Red Clay, Shell, etc.	Thick- ness Feet	Depth Feet
<u>ASHLAND, MISS</u> (Address)	<u>White dirt</u>	<u>30</u>	<u>0-20</u>
(2) Location: <u>1/4</u> , <u>1/4</u> , Sec. <u>T</u> <u>R</u>	<u>Black dirt</u>	<u>10</u>	<u>10-30</u>
<u>5</u> miles <u>SOUTH</u> , of <u>ASHLAND</u> (distance) (direction) (Nearest Town)	<u>Blue clay</u>	<u>70</u>	<u>30-100</u>
(3) Topography: <input checked="" type="checkbox"/> (Hilly) <input type="checkbox"/> (Flat) <input type="checkbox"/> (Level)	<u>sand + clay</u>	<u>40</u>	<u>100-120</u>
(4) Purpose of Well: <u>Domestic</u> (Domestic Irrigation Municipal, Industrial, Other)			
Information upon completion of well:			
(1) Diameter <u>4</u> inches.			
(2) Total Depth <u>140</u> feet.			
(3) Water Level <u>100</u> feet below top of ground.			
(4) Cased to <u>140</u> , Size <u>4"</u>			
(5) Screen: Size <u>4"</u> , Length <u>4'</u>			
(6) Were any formations sealed against pollution? <u>no</u>			
If YES depth of formation _____			
Why _____			
Drillers Remarks: _____			
_____			
_____			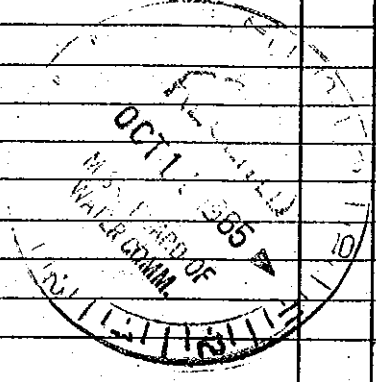
(Use Back Side)

Well No.

Mail this copy to Board of Water Commissioners 429 Miss. St. Jackson, Miss.