

Benton
H 2049
10-25-75


MISSISSIPPI
 BOARD OF WATER COMMISSIONERS
 416 North State Street
 Jackson, Mississippi 39201

WATER WELL DRILLERS LOG

Nov 25 1975 Billy R. Simpson BENTON
 date well completed firm name county well located

LANDOWNER:	description of formations encountered	from	to
<u>S. ASHLAND CHURCH OF CHRIST</u>	<u>SURFACE CLAY</u>	<u>0</u>	<u>10</u>
<u>ASHLAND, MS.</u> (mailing address)	<u>FINE RED SAND</u>	<u>10</u>	<u>23</u>
	<u>COARSE SAND</u>	<u>23</u>	<u>164</u>
WELL LOCATION:			
sec <u>15</u> T <u>3</u> S R <u>1</u> E			
<u>1</u> miles <u>S</u> of <u>ASHLAND</u>			
(distance) (direction) (nearest town)			
WELL PURPOSE: <u>CHURCH</u> (home, irrigation, municipal, industrial)			
WELL COMPLETION DATA:			
(1) diameter (inches) <u>4</u>			
(2) total depth (feet) <u>164</u>			
(3) static water level (feet) <u>119</u> below above top of ground.			
(4) casing <u>PVC</u> <u>160</u> (material) (depth)			
(size) If telescope see back.			
(5) screen <u>4'</u> <u>160</u> (length) (depth to top)			
<u>4"</u> <u>PVC</u> (size) (material)			
(6) pump <u>1/2</u> <u>10</u> (HP) (yield gpm)			
<u>ELEC</u> (type power)			
(7) electric log <u>No</u> (yes or no)			
(organization running log)			
(8) how well bottom plugged <u>PVC</u> <u>CAP</u>			

DRILLERS REMARKS:

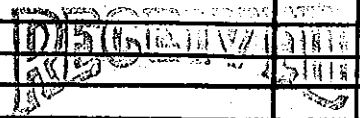

JAN 26 1976