

Benton
 J8
 4-67

MISSISSIPPI
 BOARD OF WATER COMMISSIONERS
 416 North State Street
 Jackson, Mississippi 39201

CODED

WATER WELL DRILLERS LOG

4-6 19 67 Robert Wilson Benton
 date well completed firm name county well located

LANDOWNER: John Alberson
 Ashland
 Miss.
 (mailing address)


description of formations encountered	from
Red clay	0 10
Red sand	10 40
white clay white sand	40 50
white sand	50 70

WELL LOCATION:
 sec. 11 T. 3 N. R. 2 E.
 10 7 miles E of Ashland
 (distance) (direction) (nearest town)

WELL PURPOSE:
 (home, irrigation, municipal, industrial)

- COMPLETION DATA:
- (1) diameter (inches) 4"
 - (2) total depth (feet) 70'
 - (3) static water level (feet) 40' below top of ground
 - (4) casing (material) Plastic, (depth) 66'
 - (size) 4" If telescope see back.
 - (5) screen (length) 4', (depth to top) 66'
 - (size) 4", (material) Coarse Peck
 - (6) pump 1/2 (HP), 10 (yield gpm)
 - (type power) Electric
 - (7) electric log (yes or no)
 - (organization running log)
 - (8) how well bottom plugged 4" Plastic cap

CODED

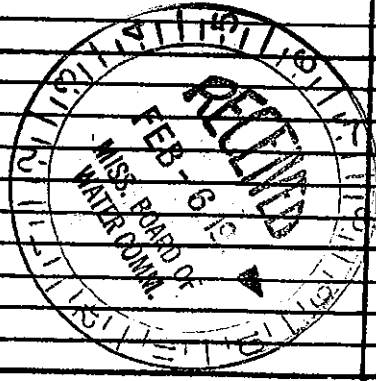

DRILLERS REMARKS: