

BENTON

MISSISSIPPI BOARD OF WATER COMMISSIONERS

J 2000

5-2-61

WATER WELL DRILLERS LOG

Date: May 2 61, 1961, Driller: Robert W. Wilson County: Benton

(Name)

<p>(1) Owner of Land: <u>John Mann</u>  <u>Ashland, Miss</u>                  (Name)                  (Address)</p>	<p>Description &amp; Color of Materials                  Sand, Clay, Red Clay, Shell, etc.  <u>Red Sand</u>  <u>White Sand</u></p>	<p>Thickness  <u>70'</u></p>	<p>Depth  <u>130'</u></p>
<p>(2) Location: <u>7</u> 1/4, <u>E</u> 1/4, Sec. <u>12</u>, T. <u>11</u>, R. <u>10</u>                  miles <u>7.11</u> of <u>Ashland</u>                  (distance) (direction) (Nearest Town)</p>			
<p>(3) Topography: <u>Hilly</u>                  (Hilly) (Flat) (Level)</p>			
<p>(4) Purpose of Well: <u>Home</u>                  (Domestic Irrigation                  Municipal, Industrial, Other)</p>			

Information upon completion of well:

(1) Diameter: 4 inches.

(2) Total Depth: 150 feet.

(3) Water level: 130 feet below top of ground.

(4) Cased to 4", Size 6".


(5) Screen: Size 4", Length 6".

(6) Were any formations sealed against pollution? X  
 yes, no.

If YES depth of formation \_\_\_\_\_

Why \_\_\_\_\_

Drillers Remarks: \_\_\_\_\_

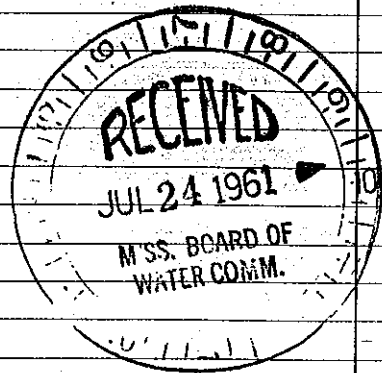

(Use Back Side)

Mail this copy to Board of Water Commissioners 429 Miss. St. Jackson, Miss.

Well No.