

BENTON

J 2003

5-13-62

MISSISSIPPI BOARD OF WATER COMMISSIONERS

WATER WELL DRILLERS LOG

Date: 5-13, 1962, Driller: O.C. Webb County Lee

(1) Owner of Land: Oscar Bumpas  
 (Name)  
Ashland miss  
 (Address)

(2) Location: 1/4, 1/4, Sec.     T.     R.      
6 miles East, of Ashland  
 (distance) (direction) (Nearest Town)

(3) Topography:  (Hilly)  (Flat)  (Level)

(4) Purpose of Well:  (Domestic Irrigation)  (Municipal, Industrial, Other)

Description & Color of Materials Sand, Clay, Red Clay, Shell, etc.	Thick- ness Feet	Dep Feet
soil to 14ft sand		
to 154ft white		
coarse sand		
blue marl		
to 460ft water		
rock 16ft water		
sand to 50ft		
blue rock to 518ft		
water rock 10ft		
water sand to		
547ft		
Overflow 46 gal		
per min		
Ripley Formation		

Information upon completion of well:

(1) Diameter 4 inches.

(2) Total Depth 547 feet.

(3) Water Level Overflow feet below top of ground.

(4) Cased to 168 ft, Size 4"

(5) Screen: Size 0, Length 0

(6) Were any formations sealed against pollution?  
    yes, 0 no.


If YES depth of formation \_\_\_\_\_

Why \_\_\_\_\_

Drillers Remarks: \_\_\_\_\_

\_\_\_\_\_

\_\_\_\_\_

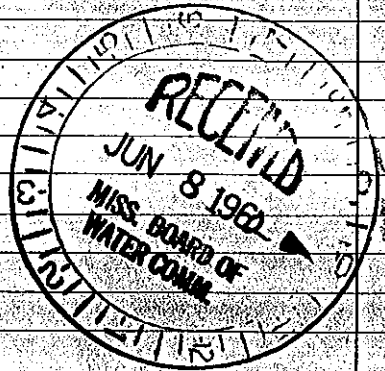

(Use Back Side)

Mail this copy to Board of Water Commissioners 429 Miss. St. Jackson, Miss

Well No.