

BENTON MISSISSIPPI BOARD OF WATER COMMISSIONERS

J 2006
2-27-64

WATER WELL DRILLERS LOG

Date: 2-27, 1964, Driller: Robert W. Wilson County Benton
(Name)

	Description & Color of Materials Sand, Clay, Red Clay, Shell, etc.	Thick- ness Feet	Depth Feet
(1) Owner of Land: <u>C. W. Bullard</u> (Name) <u>Ashton Mills</u> (Address)	<u>Red Clay - White Clay mix</u>		<u>15</u>
	<u>Blue " & Back</u>		<u>25</u>
(2) Location: <u>1/4</u> , <u>1/4</u> , Sec. <u> </u> T. <u> </u> R. <u> </u>	<u>" "</u>		<u>35</u>
<u>8</u> miles <u>S</u> of <u>Hayward</u> (distance) (direction) (Nearest Town)	<u>" "</u>		<u>65</u>
(3) Topography: <u>X</u> (Hilly) (Flat) (Level)	<u>" "</u>		<u>105</u>
(4) Purpose of Well: <u>Home</u> (Domestic Irrigation Municipal, Industrial, Other)	<u>" Sand</u>		<u>125</u>
	<u>" "</u>		<u>145</u>
	<u>" "</u>		<u>165</u>
	<u>" "</u>		<u>175</u>
	<u>" "</u>		<u>185</u>
	<u>" "</u>		<u>195</u>


Information upon completion of well:

- (1) Diameter 4 inches.
- (2) Total Depth 195 feet.
- (3) Water Level 60' feet below top of ground.
- (4) Cased to 195, Size 4
- (5) Screen: Size 4, Length 6'
- (6) Were any formations sealed against pollution?
_____ yes, _____ no.

If YES depth of formation _____

Why _____

Drillers Remarks: _____

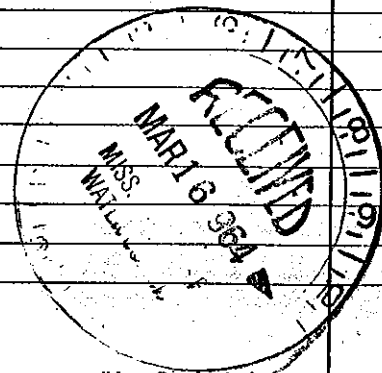

(Use Back Side)

Well No.

Mail this copy to Board of Water Commissioners 429 Miss. St. Jackson, Miss.