


Benton
 J 2008
 11-18-75

MISSISSIPPI
 BOARD OF WATER COMMISSIONERS
 416 North State Street
 Jackson, Mississippi 39201

WATER WELL DRILLERS LOG

Nov 18 1975 date well completed
 JT medlin firm name
 Benton county well located

LANDOWNER:	description of formations encountered	from	to
New Hope Baptist Ch	CLAY	0	20
Ashland Miss (mailing address)	SAND	20	75
WELL LOCATION: sec. 1 ² 15F S 1/2 E 15F (distance) (direction) (nearest town)	CLAY	75	120
WELL PURPOSE: CHURCH (home, irrigation, municipal, industrial)	SAND + ROCK	120	200
WELL COMPLETION DATA:			
(1) diameter (Inches) 4			
(2) total depth (feet) 200			
(3) static water level (feet) 130 below top of ground			
(4) casing Pl. 200 (material) (depth)			
4 (size) If telescope see back.			
(5) screen 10 ft 190 (length) (depth to top)			
4 Pl. (size) (material)			
(6) pump 1/2 7 (HP) (yield gpm)			
Elec (type power)			
(7) electric log (yes or no)			
(organization running log)			
(8) how well bottom plugged			
DRILLERS REMARKS:			

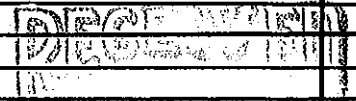

DEC 6 1975