

BENTON
J 2013
5-4-78

MISSISSIPPI
BOARD OF WATER COMMISSIONERS
416 North State Street
Jackson, Mississippi 39201

WATER WELL DRILLERS LOG

May 4 1978 Billy R. Simpson BENTON
date well completed firm name county well located

LANDOWNER:
HELEN MILLER
ASHLAND MISS
(mailing address)


description of formations encountered	from	to
SURFACE CLAY	0	2
SANDSTONE CLAY	2	26
ROCK	26	27
SAND	27	97
ROCK	97	98
BLUE CLAY	98	140
WHITE CLAY + SAND	140	145
LIGNITE	145	157
SAND	157	188
BLUE CLAY	188	237
ROCK	237	238
BLUE CLAY	238	397
ROCK	397	398
BLUE CLAY	398	401
LIMESTONE	401	421
GREEN CLAY + SAND	421	425
BLUE CLAY	425	442
ROCK + SAND	442	501

WELL LOCATION:
sec. 32 T. 3 R. 2 E.
8 miles SE of ASHLAND
(distance) (direction) (nearest town)

WELL PURPOSE: HOME
(home, irrigation, municipal, industrial)

WELL COMPLETION DATA:
(1) diameter (inches) 4
(2) total depth (feet) 501
(3) static water level (feet) 90 below top of ground.
(4) casing POC 199 (material) (depth) 199
(size) if telescope see back.
(5) screen NONE (length) (depth to top)
(size) (material)
(6) pump 1/2 (HP) 10 (yield gpm)
Elec (type power)
(7) electric log No (yes or no)
(organization running log)
(8) how well bottom plugged None

DRILLERS REMARKS:

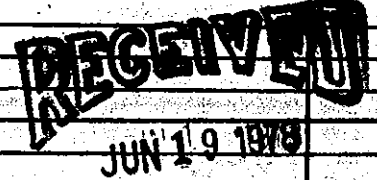

MISS. BD. OF WATER COMM