

Benton
K9
3-67

MISSISSIPPI
BOARD OF WATER COMMISSIONERS
416 North State Street
Jackson, Mississippi 39201

WATER WELL DRILLERS LOG

CODED

3-21 1967 Robert Wilson
date well completed firm name county well located

LANDOWNER: United Community Action Committee
Ashland Miss. (Royer)
(mailing address)


description of formations encountered	from	to
Red Clay	0	20
Red Silt	20	60
White Clay White Sand	60	70
White Sand	70	110

WELL LOCATION:
sec. 11 T. 4 N. R. 1 E.
10 miles SW of Ashland
(distance) (direction) (nearest town)

WELL PURPOSE:
(home, irrigation, municipal, industrial)

- WELL COMPLETION DATA:
- (1) diameter (inches) 4"
 - (2) total depth (feet) 110'
 - (3) static water level (feet) 70' below top of ground.
 - (4) casing Plastic, 106'
(material) (depth)
4" if telescope see back.
(size)
 - (5) screen 4', 106'
(length) (depth, to top)
4, Gravel Pack
(size) (material)
 - (6) pump 1/2, 10
(HP) (yield gpm)
Elect.
(type power)
 - (7) electric log yes (yes or no)
(organization running log)
 - (8) how well bottom plugged 4"
Plastic Cap

CODED

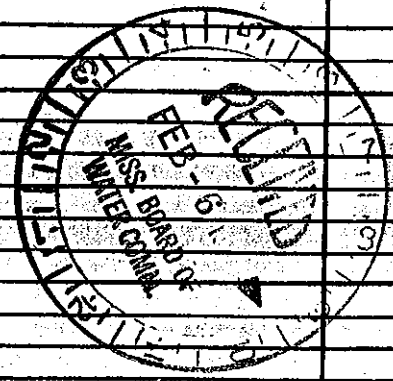

DRILLERS REMARKS: