	State Well Report	
County: Berton	Part 1 – Driller's Log	For Office Use Only:
	Mississippi Department of Environmental Quality	Aquifer:
Permit #:	Office of Land and Water Resources	Well #: K. RC
Driller: Jones W. Mason	P.O. Box 10631	Well #: <u>A - A</u>
	Jackson, MS 39289-0631	L. S. Elevation:
Date drilling completed: 12-31-05	(601)961-5210	
	(601)354-6938 (fax)	E-log #:

e

State Law requires that this report be prepared by the license holder responsible for the work and filed with the Department at the above address within 30 days of completion of drilling of the well or borehole. Information on Well Owner (Landowner if borehole is not for a water well) Latinude: 34 ° 43 ,965", Longitude: 89 ° 17 ,927

(Landowner if borehole is not for a water well)	DULLOUT ON IN THE				
Owner Name Gene Mc.Coy.	Latitude: $34 \cdot 43$, 965, Longitude: $89 \cdot 17$, 997 , 58 13				
Mailing Address: 3025 lover Gurley rd.	Method of Lat/Long (circle one): Conventional Survey,				
	USGS quad, Hand-held GPS, Survey-grade GPS				
Potto Comp MS 38659 City State Zip Code	$\frac{NE}{NW} \stackrel{4}{SE} \stackrel{5}{V5} \operatorname{Twn} \stackrel{4}{V5} \operatorname{Rng} \stackrel{1}{W} \stackrel{1}{SE} \stackrel{1}{V5} \operatorname{Nearest Town} \stackrel{1}{G^{1}} \stackrel{1}{\Delta} \operatorname{Miles} \stackrel{5}{S^{22}} \operatorname{of} \stackrel{4}{A} \stackrel{1}{S} \stackrel{1}{V} \operatorname{Ord} \stackrel{1}{A} \stackrel{1}{S} \stackrel{1}{V} \operatorname{Ord} \stackrel{1}{S} \stackrel{1}{V} \stackrel{1}{S} \stackrel{1}{$				
Telephone No. (1003-333-9136					
Well / Bore	hole Data				
Date drilling started: 12-31-05 Date drilling completed: 12-31-05 Hole depth: 200 Hole diameter: 63/4					
Location of the source of any surface water used for drilling:トム Method of dosing and volume of Chlorine used in drilling and development:					
Logs run (circle all applicable): No log run Electric Gamma Ray Density Sonic Neutron Other:					
Purpose of borehole (check one): Water Well Geotechnical/Geological Investigation Ground Source Heat Pump					
Seismic SurveyOther (describeOther (describeOther (describeOther (describeOther					
Purpose of Well (check one): Home \swarrow Industrial Public Supply Irrigation Fish Culture Other:					
If a flowing well, method of flow regulation: Valve $\mathcal{N}^{\mathcal{A}}$ Other (describe)					
Static Water Level: 112 feet above or below (circle one) land surface Date measured: 12-31-05					
Method of Measurement (circle one) steel tape electric tape air line other: String I weight					
Well depth: <u>300</u> Well grouted to a depth of <u>10</u> feet Type of grout (circle one): Neat Cement Bentonite Mix					
Casing length: <u>180</u> feet Casing diameter: <u>4</u> inches Type of casing: <u>puc</u>					
Screen length:					
Screen slot size:					
Type of completion (circle all applicable): Gravel packed Underreamed Telescoped Open hole Natural Development					
Other (describe):					
Top of lap pipe or reduction in casing: feet. <u>If telescoped or more than one screen, describe on next page</u>					

Form: OLWR-SWR-1A

FEB 0 6 2006 BY: OLWR

K-30


The sketch below only required for water wells

If well telescopes, show depths on sketch. Ground Level_

Description of formations encountered must be provided for all			
wells and boreholes, unless specifically exempted by regulations			

Description of Formations Encountered	From (depth)	10
	15	~
		30
white sad	30	70
while day	70	<u> </u>
_ Nock	05	- 51
Blue clay	<u> </u>	1>
Pock 1	170	()
gray sound.	171	30
······································		
•• • • • •		
11.8		

If more than one screen, show location of each on sketch

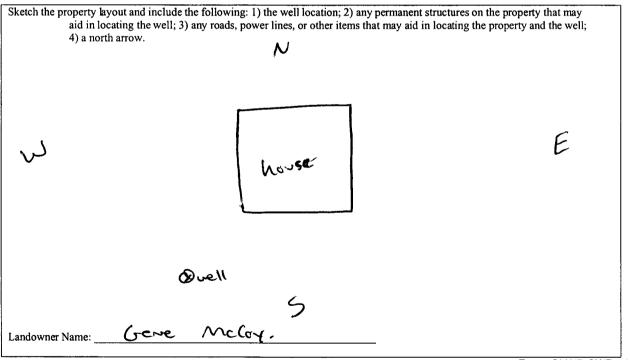

Form: OLWR-SWR-1A

I certify that the well/borehole was drilled, constructed, and completed in accordance with all applicable requirements of the Mississippi Department of Environmental Quality and the Mississippi Department of Health regulations, if applicable, and state

laws. 1-26-06 Masa . **دب** ones

Print Name of Responsible Licensee and License No.

Date

¹Signature of Licensee

FEB 0 8 2008 **BY: OLWR**

RECEIVED

STATE WELL REPORT					
County: Berton / Pump Installer's Permit #: Driller: Joes J Noso / Office of Land a P.O. F Date completed: 12-31-05 / Jackson, N (601) Copy information from block on Part 1 This part of the report must be completed by a licensed water well of report must be attached and both parts filed with the Department a Well Owner Information Owner Name: Geve McCa	art 2 s Completion Report at of Environmental Quality und Water Resources Box 10631 MS 39289-0631 961-5210 4-6938 (fax) contractor or a licensed pump installer. A copy of Part 1 of the				
Mailing Address: 30.25 lover (rurley N. Potts (onp Ms. 38659 City State Zip Code Telephone No. (662 373 9136	Method of Lat/Long (check one): Conventional Survey, USGS quad, Hand-held GPS, Survey-grade GPS $\underline{NE}_{4} \underline{S}_{4} \underline{S}_{4} \underline{S}_{2} \underline{T} \underline{4} \underline{S}_{R} \underline{1}_{4} \underline{S}_{4}$ Distance Direction Nearest Town $\underline{G}_{12} \underline{Miles} \underline{S}_{4} \underline{S}_{4} \underline{of} \underline{A} \underline{S}_{4} \underline{1}_{4} \underline{S}_{4} \underline{S}_{5} S$				
Pump Type Circle one Air Lift Jet Submersible Bucket Piston Turbine Centrifugal Rotary Flowing Well Other (specify): Poe Ducket Date Pump Installed:	Power Type Circle one Diesel Engine Gasoline Engine Natural Gas Electric Motor Hand Tractor PTO Windmill Other (specify):				
Pump Test Data Date Well Tested: $12 - 31 - 05$ Static Water Level (A): 112 Feet Below Land Surface Pumping Water Level (B): \mathcal{M}^A Feet Below Land Surface Drawdown [(B) - (A)]: $\mathcal{N}A$ Feet Below Land Surface Test Pumping Rate: 12 Gallons Per Minute Duration of Pump Test (minimum 4 hours): 24 hours	Method of Measuring Water Level Circle one Air Line Electric Measuring Line Steel Tape Other (specify): $Striwg(weight)$ $Striwg(weight)$ For flowing well, measured shut in head: NA feet Well yielded $I2$ GPM with a drawdown of NA feet after ∂I hours of pumping				

•

1;

I HEREBY CERTIFY that the above statements are true to the best of my knowledge. <u>Jones</u> <u>Jo</u>

> FEB 0 6 2006 BY: OLWB