

Benton
L21
6-66

MISSISSIPPI
BOARD OF WATER COMMISSIONERS
416 North State Street
Jackson, Mississippi 39201

WATER WELL DRILLERS LOG

CODED

6-8 1966 Robert W. Wilson 0125
date well completed Wilson Well Co. Benton
county well located

LANDOWNER: Tennison Royster
Ashland
Miss.
(mailing address)

description of formations encountered

	from	to
Red dirt	0	10
Red Sand	10	80
White Sand	80	116

WELL LOCATION:
sec. 15 T 4 N R. 1 E
1.1 miles S of EE Bryant
(distance) (direction) (nearest town)

WELL PURPOSE: Home
(home, irrigation, municipal, industrial)

WELL COMPLETION DATA:

(1) diameter (inches) 4"

(2) total depth (feet) 110'

(3) static water level (feet) 80 below above top of ground.

(4) casing Plastic 106'
(material) (depth)
4"
(size) if telescope see back.

(5) screen 4' 106'
20gaw (length) (depth to top)
4" Gal. Pac. Slotted Pipe
(size) (material)


(6) pump 1/2
(HP) (yield gpm)
Elect.
(type power)

(7) electric log NO
(yes or no)

(organization running log)

(8) how well bottom plugged 4"
Plastic Cap

CODED

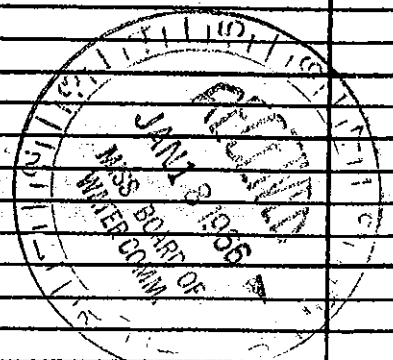

DRILLERS REMARKS: