

BENTON
 N11
 7-68

MISSISSIPPI
 BOARD OF WATER COMMISSIONERS
 416 North State Street
 Jackson, Mississippi 39201

WATER WELL DRILLERS LOG

CODED

July 8 1968
 date well completed

J. T. Medlin
 firm name

Mississippi
 county well located


LANDOWNER: Mr. Lewis
Ashland, Miss.
 (mailing address)

description of formations encountered	from	to
red clay	0	30
red sand	30	100
white sand	100	135

WELL LOCATION:
 sec. 15 T. 5 N R. 1 E
2 miles NE of Patterson
 (distance) (direction) (nearest town)

WELL PURPOSE: Home
 (home, irrigation, municipal, industrial)

- WELL COMPLETION DATA:
- (1) diameter (inches) 4"
 - (2) total depth (feet) 135 ft.
 - (3) static water level (feet) 100 ^{below} _{above} top of ground.
 - (4) casing plastic, 135'
 (material) (depth)
 - (size) if telescope see back.
 - (5) screen 20', 115'
 (length) (depth to top)
 - 4", plastic
 (size) (material)
 - (6) pump 1/2 hp, 8 gal.
 (HP) (yield gpm)
 - electric
 (type power)
 - (7) electric log no
 (yes or no)
 - (organization running log)
 - (8) how well/bottom plugged blue clay

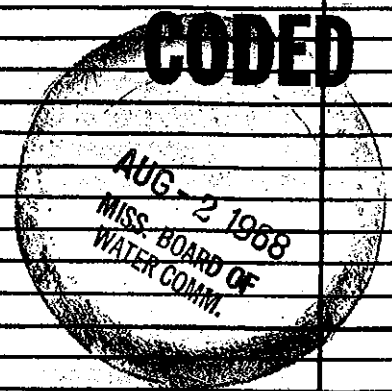

DRILLERS REMARKS: