


BENTON MISSISSIPPI BOARD OF WATER COMMISSIONERS

N 2000
5-2-66

WATER WELL DRILLERS LOG

Date: May 2, 1966, Driller: Ed Cook County Benton
(Name)

(1) Owner of Land: <small>(Name)</small>	Description & Color of Materials <small>Sand, Clay, Red Clay, Shell, etc.</small>	Thick- ness Feet	Depth Feet
<u>J.P. Todd</u> <small>(Name)</small>	<u>Red clay</u>	<u>20</u>	
<u>Hickory flat miss</u> <small>(Address)</small>	<u>Red Rock</u>	<u>2</u>	<u>20</u>
(2) Location: <u>1/4</u> , <u>1/4</u> , Sec. <u>1</u> T <u>R</u>	<u>Blue mar</u>	<u>3</u>	<u>30</u>
<u>5</u> miles <u>west</u> of <u>Hickory Flat</u> <small>(distance) (direction) (Nearest town)</small>	<u>Rock and shell</u>	<u>50</u>	
(3) Topography: <input checked="" type="checkbox"/> (Hilly) <input type="checkbox"/> (Flat) <input type="checkbox"/> (Level)			
(4) Purpose of Well: <u>home use</u> <small>(Domestic Irrigation, Municipal, Industrial, Other)</small>			
Information upon completion of well:			
(1) Diameter <u>4</u> inches.			
(2) Total Depth <u>680</u> feet.			
(3) Water Level <u>90</u> feet below top of ground.			
(4) Cased to <u>240 ft</u> , Size <u>4 in</u>			
(5) Screen: Size <u>2 in</u> , Length <u>60 ft</u>			
(6) Were any formations sealed against pollution?			
_____ yes, _____ no.			
If YES depth of formation _____			
Why _____			
Drillers Remarks: _____			

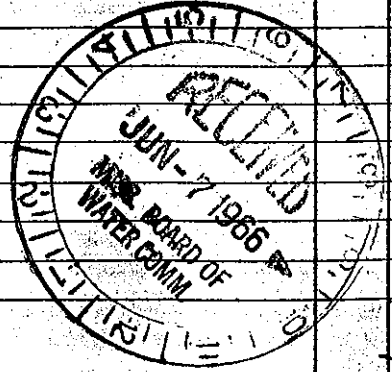

(Use Back Side)

Well No.

Mail this copy to Board of Water Commissioners 429 Miss. St. Jackson, Mis.